


Township 15 Range 10 W.M.

North

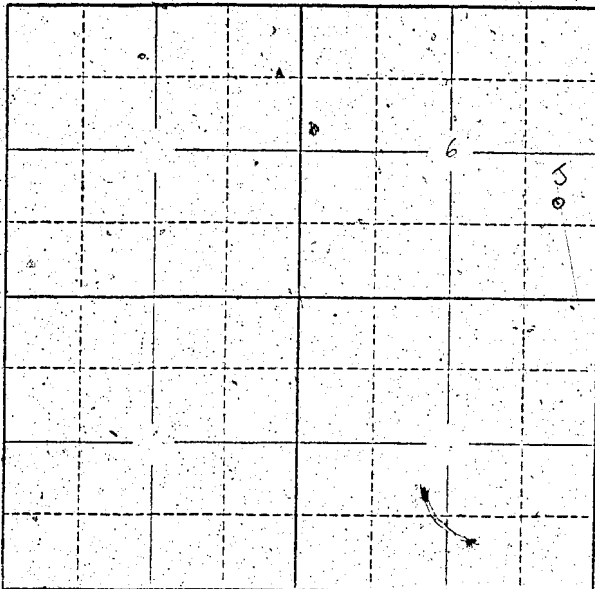

Locate well and acreage of irrigated land on plat.

Scale: 2" = 1 Mile

STATE OF OREGON

County of Washington } ss.

I, Harold J. ..., being first duly sworn, do hereby certify that I have read the foregoing Registration Statement and that all of the items therein contained are true to the best of my knowledge and belief.

[Signature]  
(Signature of Registrant)

Subscribed and sworn to before me this 11-16-21 day of November, 1921

My commission expires 11-16-22  
(Notary Public)

(SEAL)

**CERTIFICATE OF REGISTRATION**

STATE OF OREGON

County of Marion } ss.

This is to certify that the foregoing Registration Statement was received in the office of the State Engineer on the 14 day of April, 1921, at 10 o'clock A.M. and has been duly recorded in said office in Book No. 14 of Registration Statements on page 68-3296

Witness my hand this 30 day of May, 1921

[Signature]  
(State Engineer)

By \_\_\_\_\_ (Deputy)

\$16.50