


Township 17S Range 6W W.M.
North

Quinta
1st ad

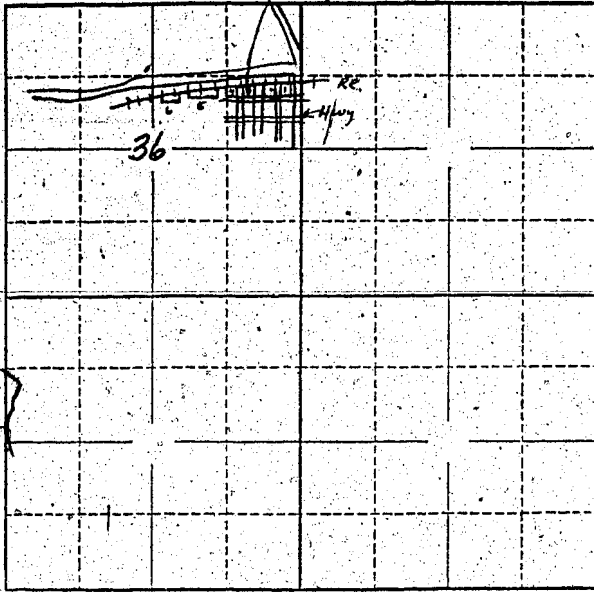

Locate well and acreage of irrigated land on plat.
Scale: 2" = 1 Mile

STATE OF OREGON

County of Marion } ss.

I, Quinta, being first duly sworn, do hereby certify that I have read the foregoing Registration Statement and that all of the items therein contained are true to the best of my knowledge and belief.

Quinta
.....
(Signature of Registrant)

Subscribed and sworn to before me this 17 day of August, 1958

My commission expires 1961

(Notary Public)

(SEAL)

CERTIFICATE OF REGISTRATION

STATE OF OREGON } ss.
County of Marion

This is to certify that the foregoing Registration Statement was received in the office of the State Engineer on the 17 day of August, 1958, at 2:00 o'clock A.M. and has been duly recorded in said office in Book No. 16 of Registration Statements on page GR 4037

Witness my hand this 11 day of April, 1960

Louis A. Stanley
.....
(State Engineer)

By

(Deputy)

\$ 20.⁰⁰

GR 4037