


Township 15 S Range 4 W, W.M.
North

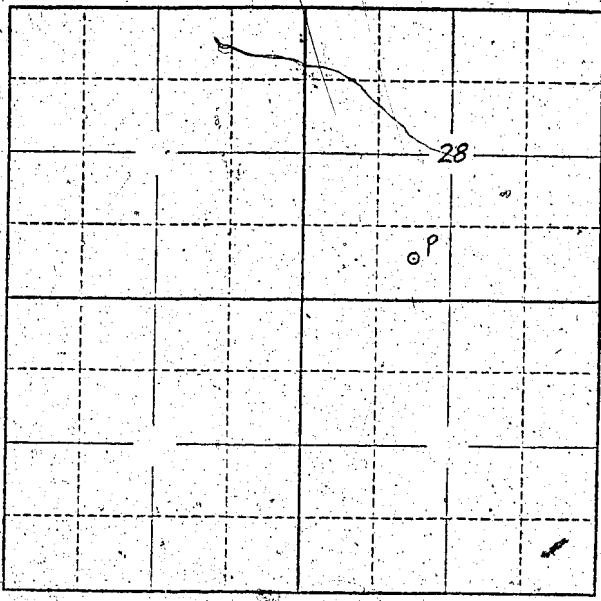

Locate well and acreage of irrigated land on plat.
Scale: 2" = 1 Mile

STATE OF OREGON

County of Marion } ss.

I, Walter A. Peterson, being first duly sworn, do hereby certify that I have read the foregoing Registration Statement and that all of the items therein contained are true to the best of my knowledge and belief.

Walter A. Peterson
(Signature of Registrant)

Subscribed and sworn to before me this 21 day of July, 1950

My commission expires Mar 28, 1951
(Notary Public)

(SEAL)

CERTIFICATE OF REGISTRATION

STATE OF OREGON }
County of Marion } ss.

This is to certify that the foregoing Registration Statement was received in the office of the State Engineer on the 14 day of August, 1950, at 11:30 o'clock A.M. and has been duly recorded in said office in Book No. 14 of Registration Statements on page GR-3301

Witness my hand this 20 day of July, 1950

\$15.25

Walter A. Peterson
(State Engineer)

By _____
(Deputy)