


Township 15S Range 4N, W.M.
North

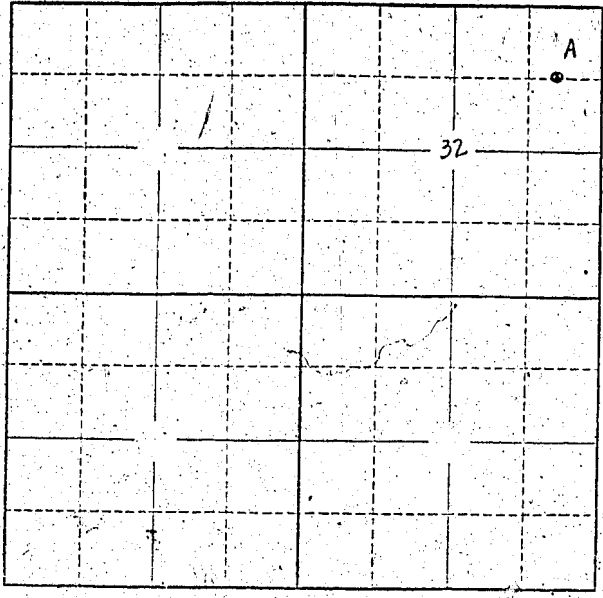

Locate well and acreage of irrigated land on plat.
Scale: 2" = 1 Mile

STATE OF OREGON


I, Walter A. Jones, being first duly sworn, do hereby certify that I have read the foregoing Registration Statement and that all of the items therein contained are true to the best of my knowledge and belief.

Walter A. Jones
(Signature of Registrant)

Subscribed and sworn to before me this 20 day of July, 1952

My commission expires July 1953
(Notary Public)

(SEAL)

CERTIFICATE OF REGISTRATION

STATE OF OREGON }
County of Marion } ss.

This is to certify that the foregoing Registration Statement was received in the office of the State Engineer on the 20 day of July, 1952, at 11:00 o'clock AM and has been duly recorded in said office in Book No. 14 of Registration Statements on page GR-3305

Witness my hand this 20 day of July, 1952

(State Engineer)

By _____ (Deputy)

GR-3305

4/5.02