


Township 11 S Range 3 W W.M.
North

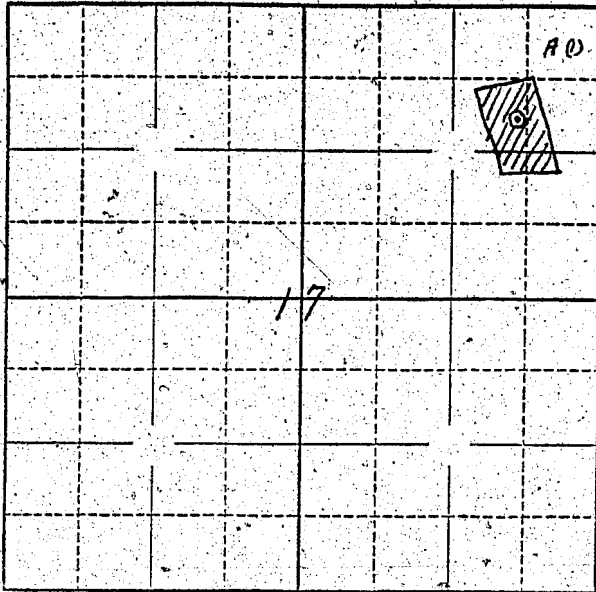

Locate well and acreage of irrigated land on plat.

Scale: $\frac{1}{4}$ " = 1 Mile

STATE OF OREGON

County of Linn } ss.

I, Eilert Meling and

I, Rosa Meling

, being first duly sworn, do hereby certify that I have read the foregoing Registration Statement and that all of the items therein contained are true to the best of my knowledge and belief.

Rosa Meling

Eilert Meling
(Signature of Registrant)

Subscribed and sworn to before me this 10th day of November, 1955

My commission expires August 4, 1957

Leronale Strat
(Notary Public)

(SEAL)

CERTIFICATE OF REGISTRATION

STATE OF OREGON

County of Marion } ss.

This is to certify that the foregoing Registration Statement was received in the office of the State Engineer on the 14th day of November, 1955, at 8:00 o'clock A. M. and has been duly recorded in said office in Book No. 1 of Registration Statements on page 31.

Construction shall be completed by 19, and the water completely applied to beneficial use by 19.

Witness my hand this 24th day of February, 1956

Lewis A. Stanley
(State Engineer)

By _____
(Deputy)