


Township 35 Range 1W W.M.

North

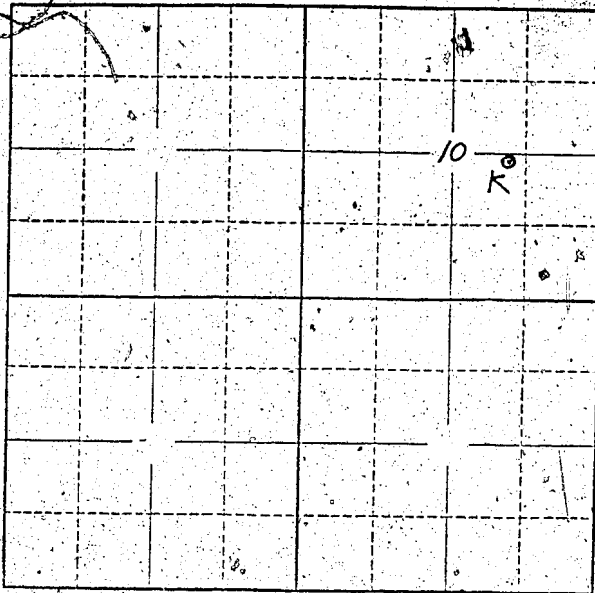

Locate well and acreage of irrigated land on plat.

Scale: 2" = 1 Mile

STATE OF OREGON

County of Washouli } ss.

I, Earl Selander, being first duly sworn, do hereby certify that I have read the foregoing Registration Statement and that all of the items therein contained are true to the best of my knowledge and belief.

Earl Selander

(Signature of Registrant)

Subscribed and sworn to before me this 20th day of July, 1959

My commission expires Jan 29, 1961 Walter A. Camp
(Notary Public)

(SEAL)

CERTIFICATE OF REGISTRATION

STATE OF OREGON }
County of Marion } ss.

This is to certify that the foregoing Registration Statement was received in the office of the State Engineer on the 1 day of August, 1959, at 1 o'clock A.M. and has been duly recorded in said office in Book No. 14 of Registration Statements on page GR 3306


(State Engineer)

By _____ (Deputy)

\$15.30