


33 Township 15 Range 2E, W.M. North

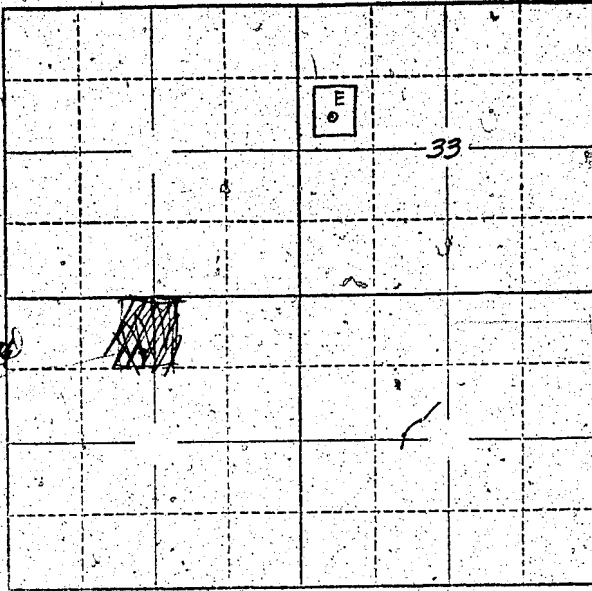

Locate well and acreage of irrigated land on plat.  
Scale: 2" = 1 Mile.

STATE OF OREGON  
County of Clackamas

ss.

I, Charles E. Yamada, being first duly sworn, do hereby certify that I have read the foregoing Registration Statement and that all of the items therein contained are true to the best of my knowledge and belief.

*Charles E. Yamada*  
(Signature of Registrant)

Subscribed and sworn to before me this 7th day of November, 1960

My commission expires  
(SEAL)

*Judith S. Sutton*  
(Notary Public)

CERTIFICATE OF REGISTRATION

STATE OF OREGON  
County of Marion

ss.

This is to certify that the foregoing Registration Statement was received in the office of the State Engineer on the 15th day of August, 1956, at 2:00 o'clock A.M. and has been duly recorded in said office in Book No. 17 of Registration Statements on page GR-4104

~~Construction shall be completed by 10/1/59 and the water completely applied to beneficial use by 10/1/59~~

Witness my hand this 12th day of December, 1960

*Lawrence A. Stanley*  
(State Engineer)

By (Deputy)

GR-4104

#15.00