


Township 11 S. Range 4 E., W.M.
North

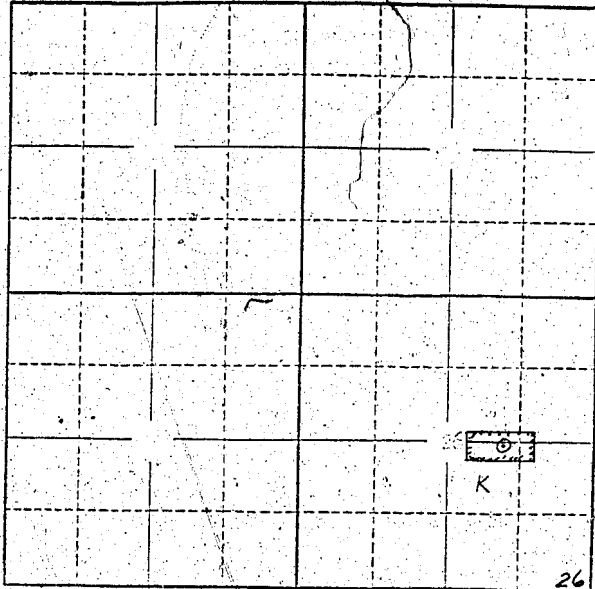

Description to be
supplemented later
by survey and plat
of certain property.

26 25
35 36

Locate well and acreage of irrigated land on plat.

Scale: 2" = 1 Mile

STATE OF OREGON

County of LINN } ss.

I, Samuel A. Walters being first duly sworn, do hereby certify that I have read the foregoing Registration Statement and that all of the items therein contained are true to the best of my knowledge and belief.

Samuel A. Walters
(Signature of Registrant)

Subscribed and sworn to before me this _____ day of _____, 19____

My commission expires _____ 19____
NOTARY PUBLIC FOR OREGON

(Notary Public)

(SEAL)

CERTIFICATE OF REGISTRATION

STATE OF OREGON } ss.
County of Marion

This is to certify that the foregoing Registration Statement was received in the office of the State Engineer on the _____ day of August, 1958, at 8:00 o'clock A.M. and has been duly recorded in said office in Book No. 14 of Registration Statements on page GR-3307

Witness my hand this 20th day of July, 1958

Walter A. Stanley
(State Engineer)

By _____ (Deputy)

\$15.00

GR-3307