


Township 1 N Range 1 E W.M.
North

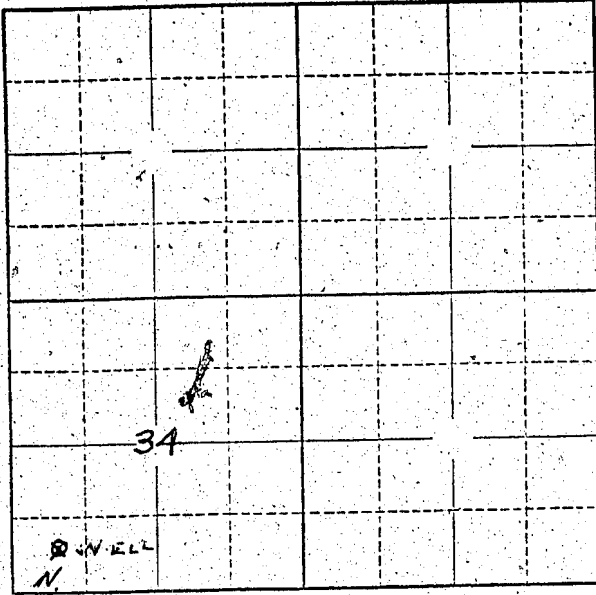

Locate well and acreage of irrigated land on plat.
Scale: 2" = 1 Mile

STATE OF OREGON

County of Multnomah

} ss.

C. I. Meyers, a Trust Officer of The
I. United States National Bank of Port/ land
read the foregoing Registration Statement and that all of the items therein contained are true to the best of
my knowledge and belief.

C. I. Meyers
.....
(Signature of Registrant)

Subscribed and sworn to before me this 24th day of July 1958

My commission expires June 1961

.....
(Notary Public)

(SEAL)

CERTIFICATE OF REGISTRATION

STATE OF OREGON

County of Marion

} ss.

This is to certify that the foregoing Registration Statement was received in the office of the State
Engineer on the 1 day of August, 1958, at 11:00 o'clock A.M. and has been
duly recorded in said office in Book No. 13 of Registration Statements on page GR-3153

Witness my hand this 18th day of June 1959

Luna A. Stanley
.....
(State Engineer)

By

.....
(Deputy)

\$20.00

GR - 3153