


Township 1 N Range 1 E, W.M.

North

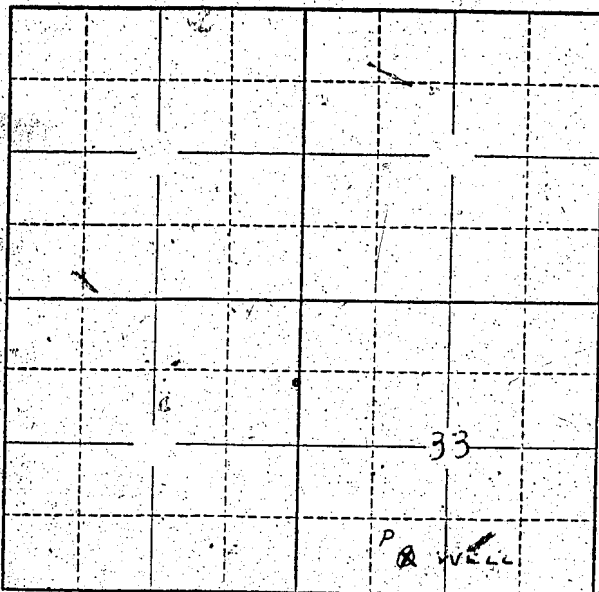

Locate well and acreage of irrigated land on plat.

Scale: 2" = 1 Mile

STATE OF OREGON

County of Multnomah

ss.

C. I. Meyers, a Trust Officer of The United

States National Bank of Portland

, being first duly sworn, do hereby certify that I have read the foregoing Registration Statement and that all of the items therein contained are true to the best of my knowledge and belief.

C. I. Meyers
(Signature of Registrant)

Subscribed and sworn to before me this 25th day of July, 1958

My commission expires Jan 2/1961

C. A. [Signature]
(Notary Public)

(SEAL)

CERTIFICATE OF REGISTRATION

STATE OF OREGON

County of Marion

ss.

This is to certify that the foregoing Registration Statement was received in the office of the State Engineer on the 1 day of August, 1958, at 11 o'clock A. M. and has been duly recorded in said office in Book No. 13 of Registration Statements on page GR-3155

Witness my hand this 18th day of June, 19 59

Lawrence A. Stanley
(State Engineer)

By _____ (Deputy)

\$20.00