


Township 17 S Range 3 W, W.M.

North

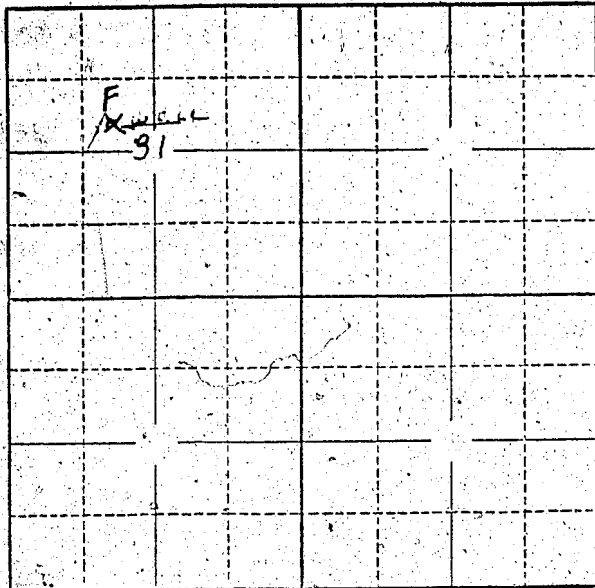

Locate well and acreage of irrigated land on plat.

Scale: 2" = 1 Mile

STATE OF OREGON

County of Multnomah

} ss.

C. I. Meyers, a Trust Officer of The United

I, States National Bank of Portland, being first duly sworn, do hereby certify that I have read the foregoing Registration Statement and that all of the items therein contained are true to the best of my knowledge and belief.

*C. I. Meyers*

(Signature of Registrant)

Subscribed and sworn to before me this 26th day of July, 19 58

My commission expires Jan. 9, 1961

*[Signature]*

(Notary Public)

(SEAL)

**CERTIFICATE OF REGISTRATION**

STATE OF OREGON

County of Marion

} ss.

This is to certify that the foregoing Registration Statement was received in the office of the State Engineer on the 26th day of August, 1958, at 5:00 o'clock P. M. and has been duly recorded in said office in Book No. 13 of Registration Statements on page GR-3156

Witness my hand this 18th day of June, 19 59

*Lewis G. Parley*

(State Engineer)

By

(Deputy)

\$ 20.00