


Township 45 Range 2W W.M.  
North

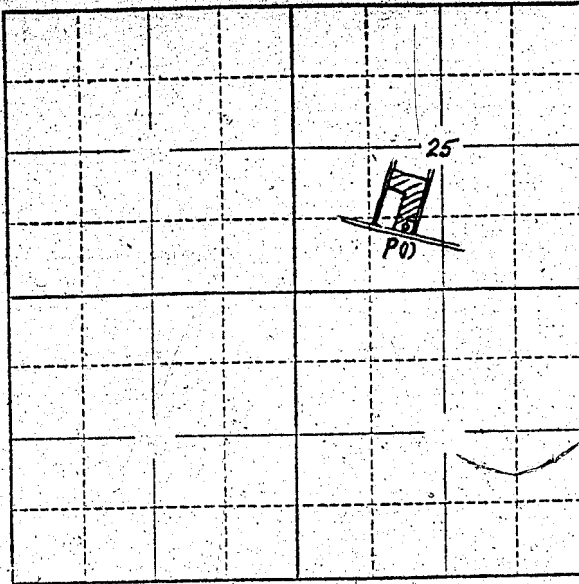

Locate well and acreage of irrigated land on plat.  
Scale: 2" = 1 Mile

STATE OF OREGON }  
County of \_\_\_\_\_ } ss.

I, Carl Brooks being first duly sworn, do hereby certify that I have read the foregoing Registration Statement and that all of the items therein contained are true to the best of my knowledge and belief.

Carl Brooks  
(Signature of Registrant)

Subscribed and sworn to before me this 7th day of February, 1957

My commission expires Sept 8, 1960  
Charles [Signature]  
(Notary Public)

(SEAL)

**CERTIFICATE OF REGISTRATION**

STATE OF OREGON }  
County of Marion } ss.

This is to certify that the foregoing Registration Statement was received in the office of the State Engineer on the 7th day of February, 1957, at 12:00 o'clock A. M. and has been duly recorded in said office in Book No. 2 of Registration Statements on page GR-347-C.


Witness my hand this 30th day of April, 1957  
Lewis A. Stanley  
(State Engineer)

#15.00

By \_\_\_\_\_ (Deputy)