


Township 7S Range 3W, W.M.
North

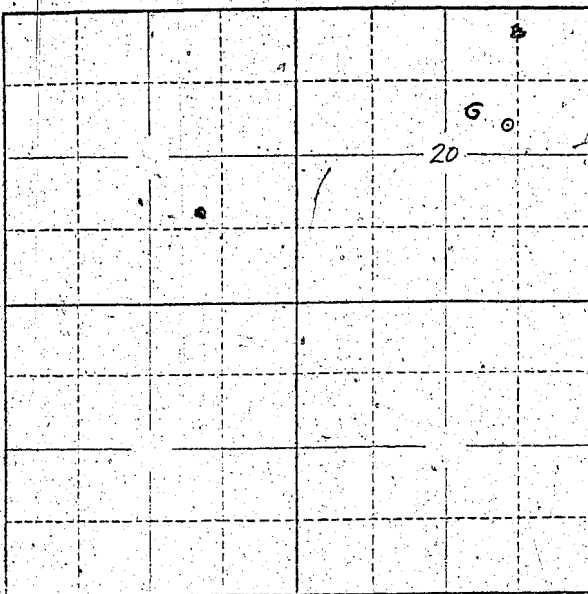

Locate well and acreage of irrigated land on plat.
Scale: 2" = 1 Mile

STATE OF OREGON

County of Marion

ss.

I, Rollie Beaver Myrtle Beaver being first duly sworn, do hereby certify that I have read the foregoing Registration Statement and that all of the items therein contained are true to the best of my knowledge and belief.

Rollie Beaver Myrtle Beaver
(Signature of Registrant)

Subscribed and sworn to before me this 1st day of August, 1958

My commission expires 12th June 1961

W.M.O. Bratholmeers
(Notary Public)

(SEAL)

CERTIFICATE OF REGISTRATION

STATE OF OREGON

County of Marion

ss.

This is to certify that the foregoing Registration Statement was received in the office of the State Engineer on the 1st day of August, 1958 at 3:22 o'clock P.M. and has been duly recorded in said office in Book No. 14 of Registration Statements on page GR-3313

Witness my hand this 20th day of July, 1959

W.M.O. Bratholmeers
(State Engineer)

[Signature]
(Deputy)

GR - 3313