


North

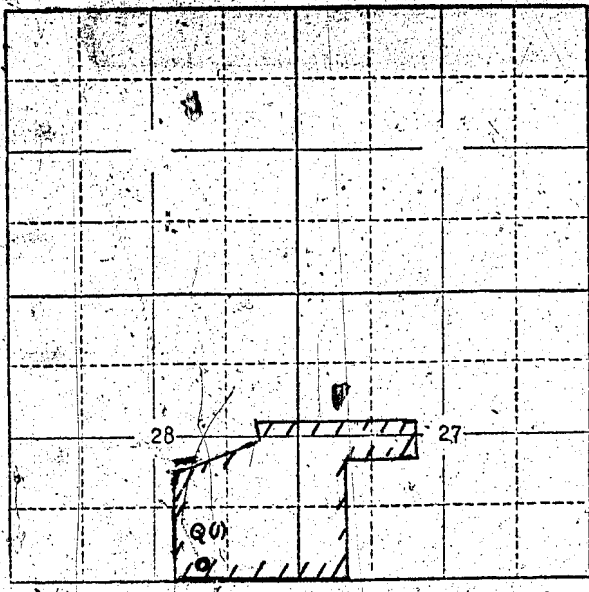

- /// Use area
- o well

Locate well and acreage of irrigated land on plat.  
 Scale: 2" = 1 Mile

STATE OF OREGON

County of Multnomah

City of Fairview by

I, Thomas L. Shaw

being first duly sworn, do hereby certify that I have read the foregoing Registration Statement and that all of the items therein contained are true to the best of my knowledge and belief.

by *Thomas L. Shaw* Water Supt.  
 (Signature of Registrant)

Subscribed and sworn to before me this 1 day of February, 1957.

My commission expires 3/15/1957.

*Mrs. Betty J. Shaw*  
 (Notary Public)

(SEAL)

CERTIFICATE OF REGISTRATION

STATE OF OREGON

County of Marion

This is to certify that the foregoing Registration Statement was received in the office of the State Engineer on the 7th day of February, 1957, at 9:00 o'clock A.M. and has been duly recorded in said office in Book No. 2 of Registration Statements on page QR-349 C.


Witness my hand this 30th day of April, 1957.

*Lewis A. Stanley*  
 (State Engineer)

By \_\_\_\_\_ (Deputy)

\$ 20.<sup>00</sup>