


North

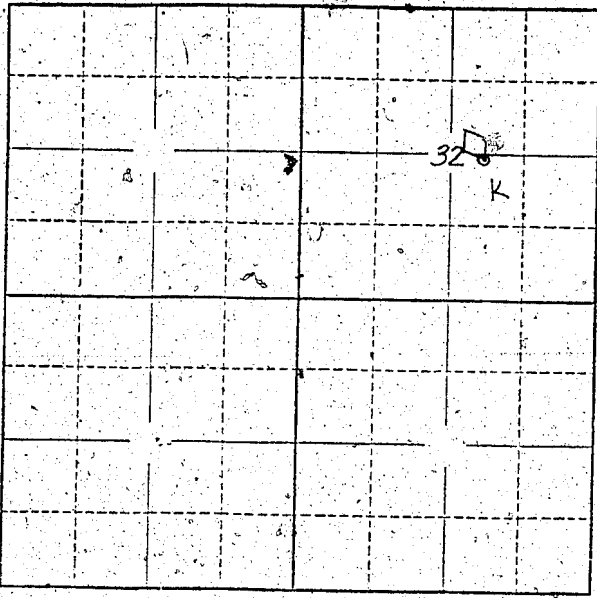

Locate well and acreage of irrigated land on plat. Scale: 2" = 1 Mile

STATE OF OREGON

County of Jackson } ss.

I, [Signature], being first duly sworn, do hereby certify that I have read the foregoing Registration Statement and that all of the items therein contained are true to the best of my knowledge and belief.

[Signature] (Signature of Registrant)

Subscribed and sworn to before me this 29th day of July, 1958

My commission expires [Signature] NOTARY PUBLIC FOR OREGON My Commission Expires Dec. 17, 1958

(Notary Public)

(SEAL)

CERTIFICATE OF REGISTRATION

STATE OF OREGON } ss. County of Marion

This is to certify that the foregoing Registration Statement was received in the office of the State Engineer on the [Signature] day of August, 1958, at [Signature] o'clock [Signature] M. and has been duly recorded in said office in Book No. 14 of Registration Statements on page GR-3327

Witness my hand this 20th day of August, 1958

4,500

[Signature] (State Engineer)

By: [Signature] (Deputy)