Township 4N Range 1 W, W.M.

North

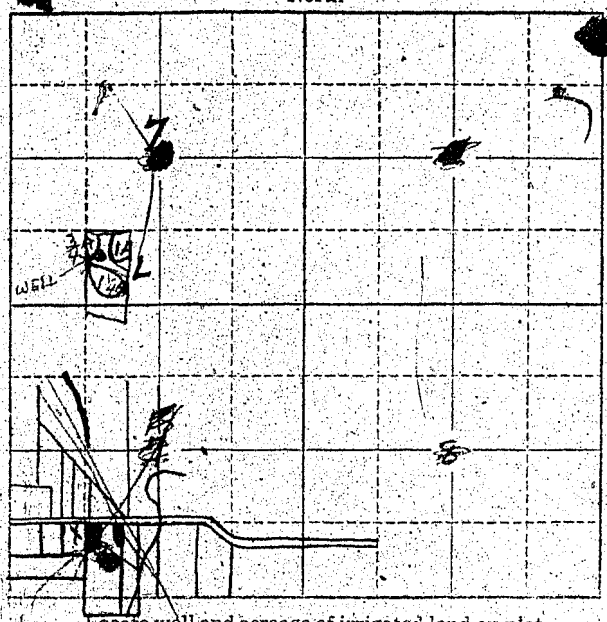

Locate well and acreage of irrigated land on plat.

Scale: 2" = 1 Mile

STATE OF OREGON
County of Columbia } ss.

I, Tony Moros and Fannie Moros, being first duly sworn, do hereby certify that I have read the foregoing Registration Statement and that all of the items therein contained are true to the best of my knowledge and belief.

TONY MOROS and Fannie Moros
(Signature of Registrant)

Subscribed and sworn to before me this 28th day of Jan. 1960

My commission expires 3-14-63

NOTARY PUBLIC FOR OREGON
MY COMMISSION EXPIRES MAR. 14, 1963

(Notary Public)

(SEAL)

CERTIFICATE OF REGISTRATION

STATE OF OREGON
County of Marion } ss.

This is to certify that the foregoing Registration Statement was received in the office of the State Engineer on the 1st day of August 1958, at 8:00 o'clock A M. and has been duly recorded in said office in Book No. 16 of Registration Statements on page GR-3950

~~Construction shall be completed by ... 19 ... and the water completely applied ... 19~~

Witness my hand this 15th day of February 1960

Lewis A. Stanley
(State Engineer)

$15.00

By
(Deputy)

GR-3950