

Scale: 2" = 1 Mile

County of _____

L. G. Gentry
(Signature of Registrant)

My commission expires _____ (Notary Public)


STATE OF OREGON } ss.
County of Marion }

XX This is to certify that the foregoing Registration Statement was received in the office of the State
Engineer on the X-X-X-X day of X-X-X-X-X-X-X-X-X-X at X-X-X-X-X-X'clock X-X-X-M and has been
thoroughly examined in said office in Book No. X-X-X-X-X-X of Registration Statements on page X-X-X-X-X-X-
XX Construction shall be completed by X-X-X-X-X-X--X-X-X-X and the water completely applied to
X-X

(State Engineer)

By _____ (Deputy)

Township 25 Range 4 N. W.M.
North

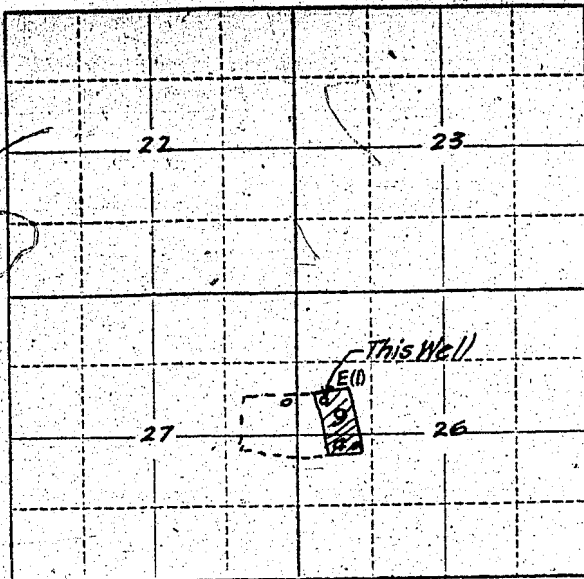

Locate well and acreage of irrigated land on plat.

Scale: 2" = 1 Mile

STATE OF OREGON

County of _____

SS.

I, _____, being first duly sworn, do hereby certify that I have read the foregoing Registration Statement and that all of the items therein contained are true to the best of my knowledge and belief.

L. R. B. B. B.
(Signature of Registrant)

Subscribed and sworn to before me this _____ day of _____, 19____

My commission expires _____

(Notary Public)

(SEAL)

See Page GR-351 K for
CERTIFICATE OF REGISTRATION

STATE OF OREGON

County of Marion

SS.

XX This is to certify that the foregoing Registration Statement was received by the Office of the State Engineer on this _____ day of _____, 19____ and has been duly recorded in the _____ of Registration Statements, page _____ of _____.

Conservation shall be completed by _____ and the water completely applied to beneficial use by _____.

Witness my hand this _____ day of _____, 19____

(State Engineer)

By _____

(Deputy)

GR 351 G


STATE OF OREGON

County of _____

55

I, L. Dale Emery, being first duly sworn, do hereby certify that I have read the foregoing Registration Statement and that all of the items therein contained are true to the best of my knowledge and belief.

(Signature of Registrant)

Subscribed and sworn to before me this 7th day of February, 1957

My commission expires Sept 8, 1960

Chris L. Wheeler
(Notary Public)

(SEAL)

CERTIFICATE OF REGISTRATION

STATE OF OREGON

County of Marion

SS.

This is to certify that the foregoing Registration Statement was received in the office of the State Engineer on the 7th day of February, 19 57 at 11:00 o'clock A. M. and has been duly recorded in said office in Book No. 2 of Registration Statements on page GR-351 K

~~XX Construction work completed by X-X-X-X-X-X-X-X-X-X and the water supply by April 10~~

Witness my hand this 30th day of April 1957

19. 57.
Lewis G. Stanley
(State Engineer)

By

(Deputy)

GR 351 K