


Township 37S Range 2W, W.M.

North

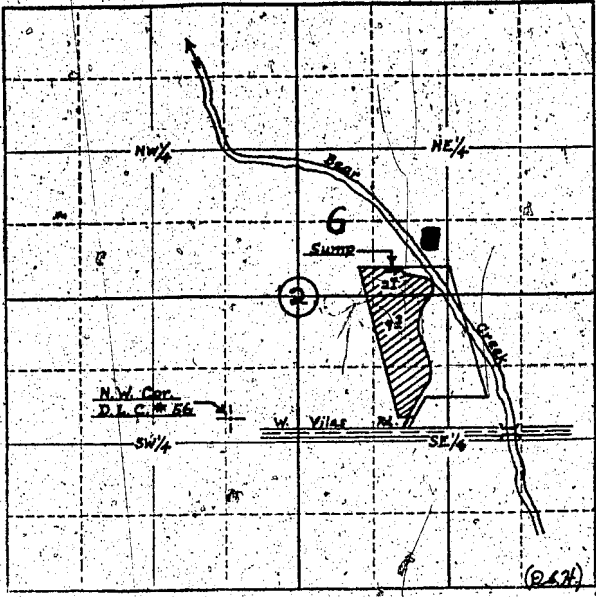

Locate well and acreage of irrigated land on plat.

Scale: 4" = 1 Mile

STATE OF OREGON

County of Jackson } ss.

I, Helen Hedrick, being first duly sworn, do hereby certify that I have read the foregoing Registration Statement and that all of the items therein contained are true to the best of my knowledge and belief.

MORGROSS FANCH

By: Helen Hedrick
(Signature of Registrant)

Subscribed and sworn to before me this 31st day of July, 1958

My commission expires October 7, 1961
(Notary Public)

(SEAL)

CERTIFICATE OF REGISTRATION

STATE OF OREGON } ss.
County of Marion

This is to certify that the foregoing Registration Statement was received in the office of the State Engineer on the 15th day of August, 1958, at 8:00 o'clock A. M. and has been duly recorded in said office in Book No. 17 of Registration Statements on page GR-4074

~~Construction shall be completed by 1960 and the water completely applied to beneficial use by 1960~~

Witness my hand this 16th day of May, 1960

LEWIS A. STANLEY
(State Engineer)

By: Max F. Rogers
(Deputy)

GR-4074

#15.00