


Township 16S Range 4W W.M.  
North

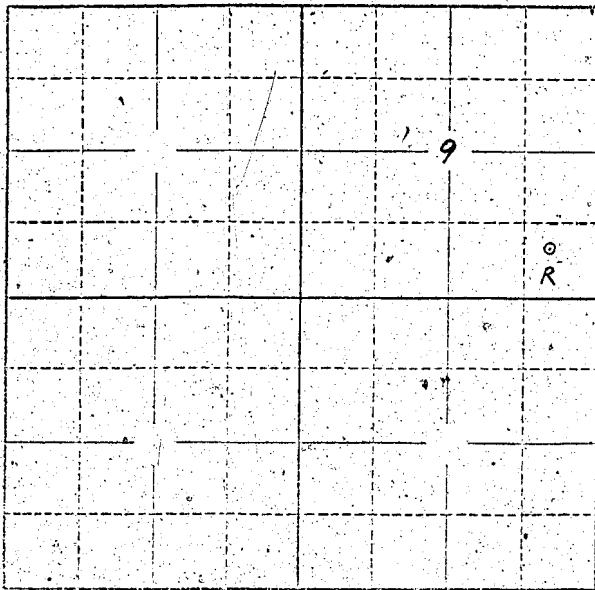

Locate well and acreage of irrigated land on plat.

Scale: 2" = 1 Mile

STATE OF OREGON

County of \_\_\_\_\_

ss.

I, Notary Public, being first duly sworn, do hereby certify that I have read the foregoing Registration Statement and that all of the items therein contained are true to the best of my knowledge and belief.

(Signature of Registrant)

Subscribed and sworn to before me this 31<sup>st</sup> day of July, 1959.

My commission expires Aug 10 1960

(Notary Public)

(SEAL)

**CERTIFICATE OF REGISTRATION**

STATE OF OREGON

ss.

County of Marion

This is to certify that the foregoing Registration Statement was received in the office of the State Engineer on the \_\_\_\_\_ day of \_\_\_\_\_, 1959, at \_\_\_\_\_ o'clock \_\_\_\_\_ M. and has been duly recorded in said office in Book No. 14 of Registration Statements on page GR-3316.

~~Construction has been completed by \_\_\_\_\_ and the water conserved is applied to beneficial use by \_\_\_\_\_.~~

Witness my hand this 20<sup>th</sup> day of August, 1959.

(State Engineer)

(Deputy)

GR-3316

\$15.00