


Township 16 S. Range 4 W., W.M.
North

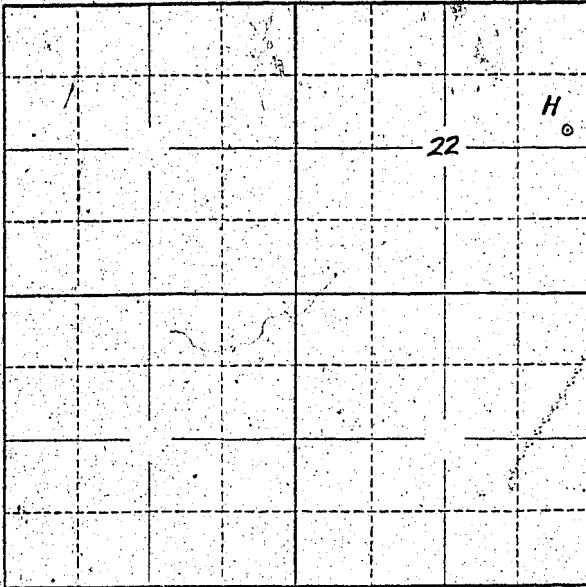

Locate well and acreage of irrigated land on plat.
Scale: 2" = 1 Mile

STATE OF OREGON

County of Lane } ss.

I, W. S. Löffelmacher, being first duly sworn, do hereby certify that I have read the foregoing Registration Statement and that all of the items therein contained are true to the best of my knowledge and belief.

W. S. Löffelmacher
Signature of Registrant

Subscribed and sworn to before me this 31st day of July, 1958.

My commission expires March 13, 1961 James M. Ben
(Notary Public)

(SEAL)

CERTIFICATE OF REGISTRATION

STATE OF OREGON } ss.
County of Marion

This is to certify that the foregoing Registration Statement was received in the office of the State Engineer on the 13th day of August, 1958, at 2:00 o'clock PM and has been duly recorded in said office in Book No. 14 of Registration Statements on page GR-3350

Witness my hand this 20th day of August, 1959
Lewis A. Stanley
(State Engineer)

By _____ (Deputy)

GR - 3350

\$16.50