


Township 16 S Range 4 W W.M.  
North

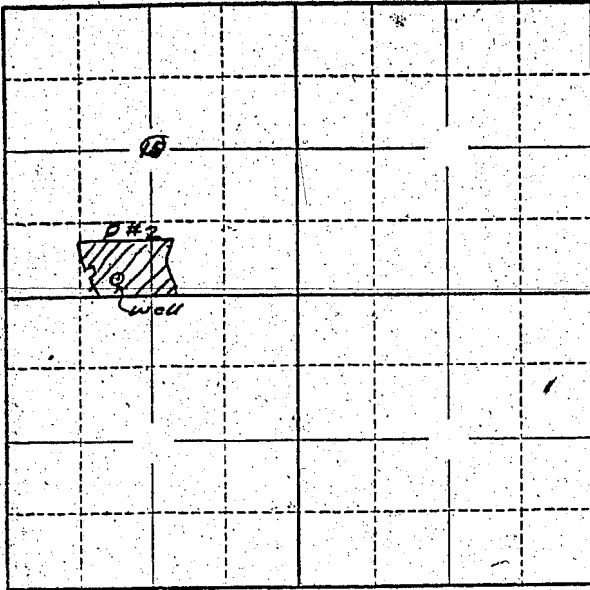

Locate well and acreage of irrigated land on plat.  
Scale: 2" = 1 Mile

STATE OF OREGON

County of Lane } ss.

I, Harold G. Frost, being first duly sworn, do hereby certify that I have read the foregoing Registration Statement and that all of the items therein contained are true to the best of my knowledge and belief.

Harold G. Frost  
(Signature of Registrant)

Subscribed and sworn to before me this 31<sup>st</sup> day of July, 1958.

My commission expires April 11, 1960.  
Alma Steedwith  
(Notary Public)

(SEAL)

**CERTIFICATE OF REGISTRATION**

STATE OF OREGON } ss.  
County of Marion

This is to certify that the foregoing Registration Statement was received in the office of the State Engineer on the 1<sup>st</sup> day of August, 1958, at 2:00 o'clock A. M. and has been duly recorded in said office in Book No. 14 of Registration Statements on page GR- 3377

Witness my hand this 20<sup>th</sup> day of August, 1959.

Lewis A. Stanley  
(State Engineer)

By \_\_\_\_\_  
(Deputy)

GR 3377

#1565