


North

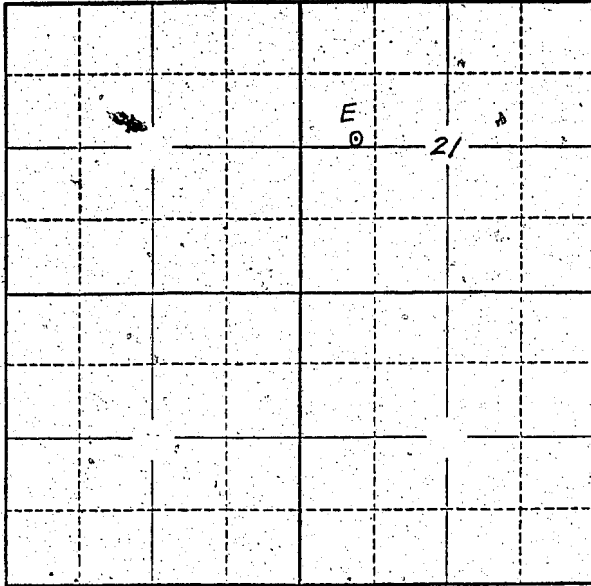

Locate well and acreage of irrigated land on plat.

Scale: 2" = 1 Mile

STATE OF OREGON

County of Benton, ss.

I, W. Guy Parker, being first duly sworn, do hereby certify that I have read the foregoing Registration Statement and that all of the items therein contained are true to the best of my knowledge and belief.

W. Guy Parker
(Signature of Registrant)

Subscribed and sworn to before me this 30th day of July, 1958.

My commission expires 11/16, 1960. *[Signature]*
(Notary Public)

(SEAL)

CERTIFICATE OF REGISTRATION

STATE OF OREGON

County of Marion, ss.

This is to certify that the foregoing Registration Statement was received in the office of the State Engineer on the 1 day of August, 1958 at 8:00 o'clock A.M. and has been duly recorded in said office in Book No. 14 of Registration Statements on page 3386

Witness my hand this 20th day of August, 1959

Lewis A. Stanley
(State Engineer)

By _____ (Deputy)

\$15.00