


Township 11s Range 3w W.M.  
North

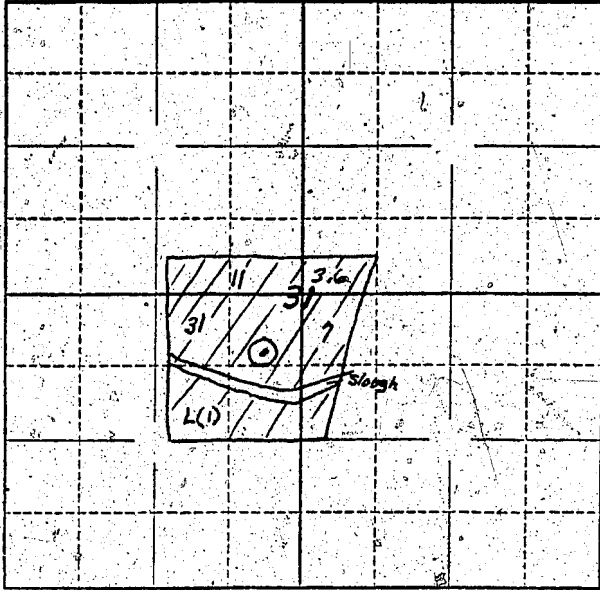

Locate well and acreage of irrigated land on plat.

Scale:  $\frac{1}{4}$ " = 1 Mile

STATE OF OREGON  
County of Linn } ss.

I, J. L. McFarland, being first duly sworn, do hereby certify that I have read the foregoing Registration Statement and that all of the items therein contained are true to the best of my knowledge and belief.

*J. L. McFarland*  
(Signature of Registrant)

Subscribed and sworn to before me this 10th day of November 1955.

My commission expires \_\_\_\_\_  
*R. M. Russell*  
County Clerk

(SEAL)

**CERTIFICATE OF REGISTRATION**

STATE OF OREGON  
County of Marion } ss.

This is to certify that the foregoing Registration Statement was received in the office of the State Engineer on the 14th day of November, 1955, at 9:00 o'clock A.M. and has been duly recorded in said office in Book No. 1 of Registration Statements on page 32.

Construction shall be completed by 15 1955, and the water is completely applied to beneficial use by 15 1955.

Witness my hand this 24th day of February, 1956.  
*Lewis A. Strubley*  
(State Engineer)

By \_\_\_\_\_  
(Deputy)