Township 37S Range 2W W.M.

North

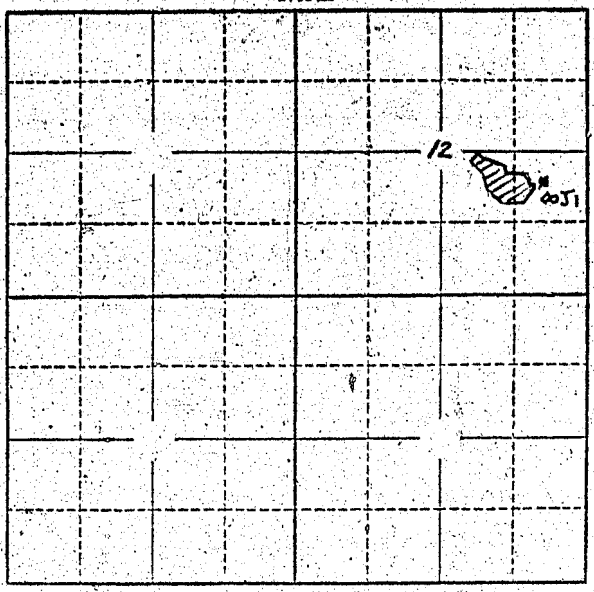

Locate well and acreage of irrigated land on plat.

Scale: 2" — 1 Mile

STATE OF OREGON
County of Jackson } ss.

I, Kenneth Cearley, being first duly sworn, do hereby certify that I have read the foregoing Registration Statement and that all of the items therein contained are true to the best of my knowledge and belief.

Kenneth L. Cearley
(Signature of Registrant)

Subscribed and sworn to before me this 13th day of Febuary, 19 57

My commission expires August 10 1957

(Notary Public)

(SEAL)

CERTIFICATE OF REGISTRATION

STATE OF OREGON
County of Marion } ss.

This is to certify that the foregoing Registration Statement was received in the office of the State Engineer on the 14th day of February, 19 57, at 8:00 o'clock A. M. and has been duly recorded in said office in Book No. 2 of Registration Statements on page GR-356 C

~~Construction work to be completed by x-x-x-x-x-x-x-x-x-x-x-x and water employed to be applied to beneficial use by x-x-x-x-x-x-x-x-x-x-x-x.~~

Witness my hand this 30th day of April, 19 57

Lewis A. Stanley
(State Engineer)

$15.00

By
(Deputy)

GR 356 C