


Township 13R Range 15W6 W.M.  
North

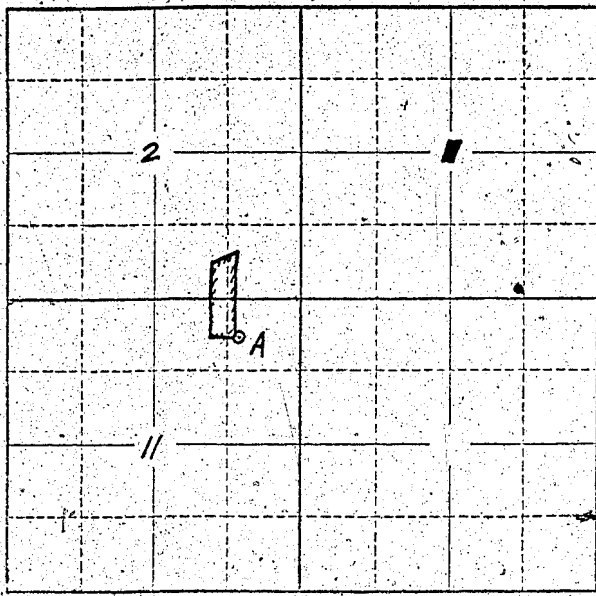

*Place in  
County  
front of  
well is  
north  
Barn*

Locate well and acreage of irrigated land on plat.  
Scale: 2" = 1 Mile

STATE OF OREGON }  
County of Tillamook } ss.

I, Bernice Wilkins, being first duly sworn, do hereby certify that I have read the foregoing Registration Statement and that all of the items therein contained are true to the best of my knowledge and belief.

*Bernice Wilkins*  
(Signature of Registrant)

Subscribed and sworn to before me this 30th day of July, 19 58

My commission expires 2/2/62  
(SEAL)

*Theresa M. Minnie*  
Notary Public for Oregon  
My Commission Expires: 2/2/62

**CERTIFICATE OF REGISTRATION**

STATE OF OREGON }  
County of Marion } ss.

This is to certify that the foregoing Registration Statement was received in the office of the State Engineer on the 1st day of August, 19 58, at 2:00 o'clock P.M. and has been duly recorded in said office in Book No. 16 of Registration Statements on page GR-3951

~~Construction shall be completed by \_\_\_\_\_ and the water completed \_\_\_\_\_  
and finished by \_\_\_\_\_~~

Witness my hand this 15th day of February, 19 60

*Laura A. Stanley*  
(State Engineer)

#1500

By \_\_\_\_\_  
(Deputy)  
**GR-3951**