


North

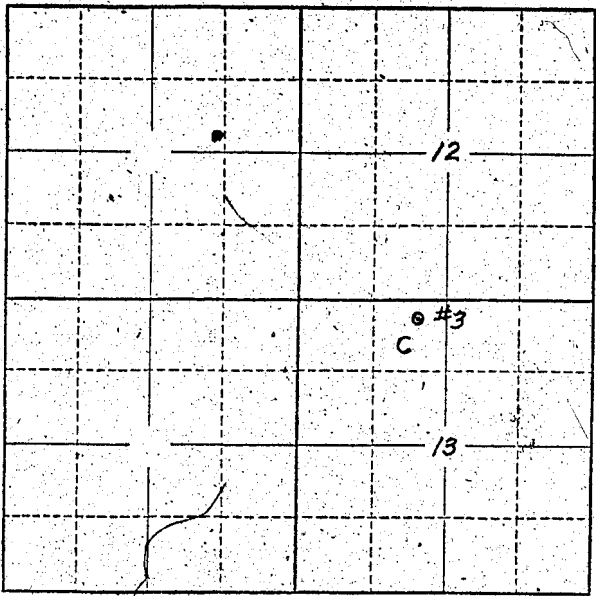

Locate well and acreage of irrigated land on plat.  
Scale: 2" = 1 Mile

STATE OF OREGON }  
County of LINN } ss.  
~~RAIMOND K BAKER~~

I, RAIMOND K BAKER, being first duly sworn, do hereby certify that I have read the foregoing Registration Statement and that all of the items therein contained are true to the best of my knowledge and belief.

Raimond K Baker  
(Signature of Registrant)

Subscribed and sworn to before me this 30 day of July, 1958

My commission expires MY COMMISSION EXPIRES MAY 22, 1962

Lillian E. Phillips  
(Notary Public)

(SEAL)

**CERTIFICATE OF REGISTRATION**

STATE OF OREGON }  
County of Marion } ss.

This is to certify that the foregoing Registration Statement was received in the office of the State Engineer on the 13<sup>th</sup> day of August, 1958, at 8:00 o'clock A.M. and has been duly recorded in said office in Book No. 16 of Registration Statements on page R- 3835

Witness my hand this 4<sup>th</sup> day of December, 1959

Lewis A. Stanley  
(State Engineer)

By \_\_\_\_\_  
(Deputy)

\$15.00