


Township 3.05 Range 11 W.M.  
North

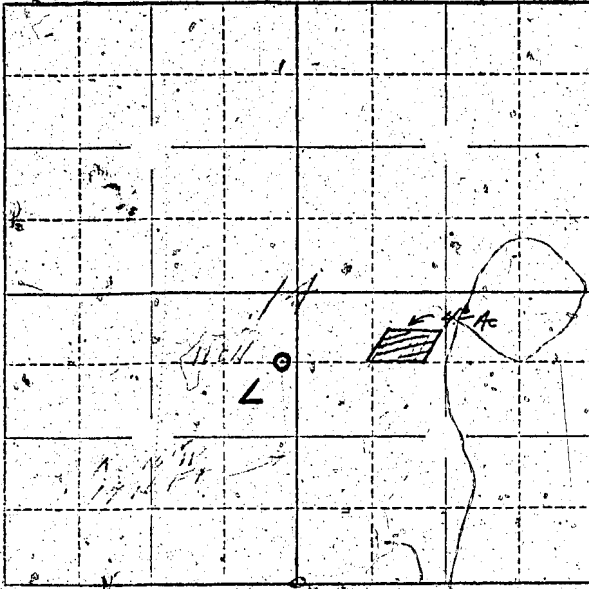

Locate well and acreage of irrigated land on plat.

Scale: 2" = 1 Mile

STATE OF OREGON


I, Mark W. Seely, being first duly sworn, do hereby certify that I have read the foregoing Registration Statement and that all of the items therein contained are true to the best of my knowledge and belief.

(Signature of Registrant)

Subscribed and sworn to before me this 31 day of August, 1958.

My commission expires

NOTARY PUBLIC FOR OREGON  
My Commission Expires July 22, 1959

(Notary Public)

(SEAL)

**CERTIFICATE OF REGISTRATION**

STATE OF OREGON

County of Marion ss.

This is to certify that the foregoing Registration Statement was received in the office of the State Engineer on the 31 day of August, 1958, at 8:00 o'clock A. M. and has been duly recorded in said office in Book No. 14 of Registration Statements on page GR-3393

~~XX Construction shall be completed by 10/1/58 and the water completely applied to beneficial use by 10/1/58 XX~~

Witness my hand this 1 day of August, 1959.

(State Engineer)

By Henry J. Stanley (Deputy)

GR-3393

\$15.00