


North

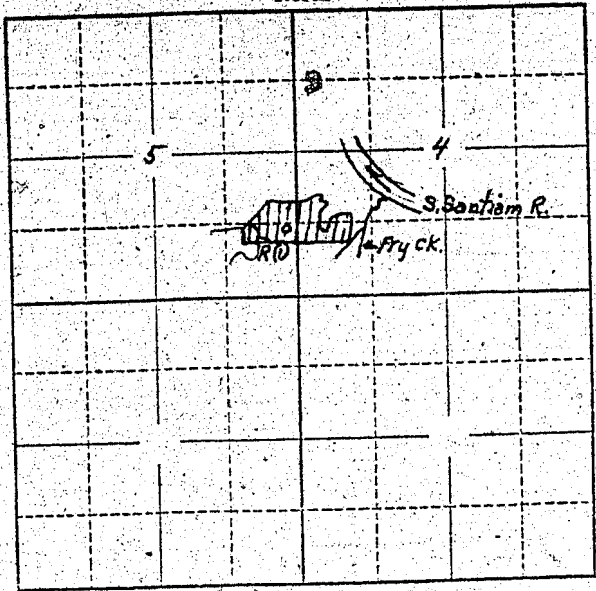

Locate well and acreage of irrigated land on plat.  
Scale: 2" = 1 Mile

STATE OF OREGON

County of Linn } ss.

I, Wilbert H. and Jane Bilveu, being first duly sworn, do hereby certify that I have read the foregoing Registration Statement and that all of the items therein contained are true to the best of my knowledge and belief.

*Wilbert H. Bilveu & Jane Bilveu*  
(Signature of Registrant)

Subscribed and sworn to before me this 5<sup>th</sup> day of February, 1957.

My commission expires Feb Nelson (Notary Public)

Commission Expires May 31, 1958

(SEAL)

**CERTIFICATE OF REGISTRATION**

STATE OF OREGON

County of Marion } ss.

This is to certify that the foregoing Registration Statement was received in the office of the State Engineer on the 18<sup>th</sup> day of February, 1957 at 8:00 o'clock A. M. and has been duly recorded in said office in Book No. 2 of Registration Statements on page GR-358 C

~~Construction shall be completed by X-X-X-X-X-X-X-X-X-X and the water right hereby applied for beneficial use by X-X-X-X-X-X-X-X-X-X~~

Witness my hand this 30<sup>th</sup> day of April, 1957.

*Lewis A. Stanley*  
(State Engineer)

By \_\_\_\_\_ (Deputy)

#1500