


North

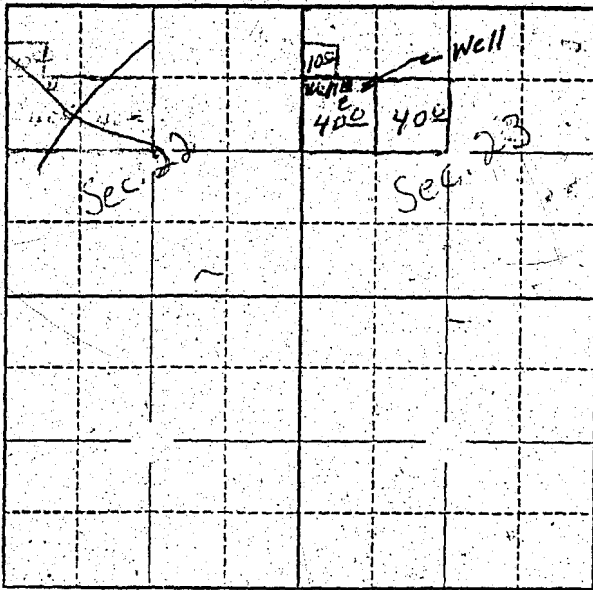

Locate well and acreage of irrigated land on plat.

Scale: 2" = 1 Mile

STATE OF OREGON

County of Clackamas

} ss.

I, Ben Kylo, being first duly sworn, do hereby certify that I have read the foregoing Registration Statement and that all of the items therein contained are true to the best of my knowledge and belief.

Ben Kylo
(Signature of Registrant)

Subscribed and sworn to before me this 1 day of August, 1958

My commission expires July 22, 1961

Arthur Johnson
(Notary Public)

(SEAL)

CERTIFICATE OF REGISTRATION

STATE OF OREGON

County of Marion

} ss.

This is to certify that the foregoing Registration Statement was received in the office of the State Engineer on the 1st day of August, 1958, at 10⁰⁰ o'clock a M. and has been duly recorded in said office in Book No. 14 of Registration Statements on page GP- 3397

Witness my hand this 20th day of August, 1958

Lewis A. Stanley
(State Engineer)

By _____ (Deputy)

\$24.00