


Sec 19

Township 10 S Range 2 W, W.M. North

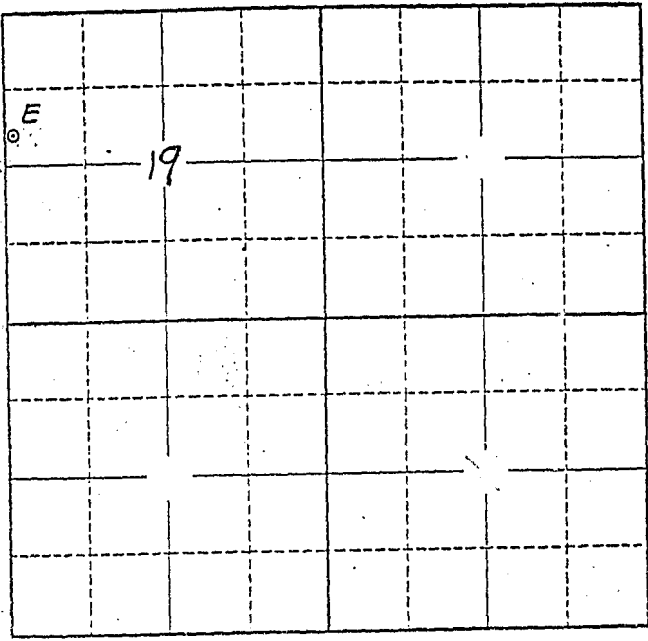

Well
Hess
Barn
West Ditch

Locate well and acreage of irrigated land on plat.
Scale: 2" = 1 Mile

STATE OF OREGON }
County of Marion } ss.

I, Harvey Mitchell, being first duly sworn, do hereby certify that I have read the foregoing Registration Statement and that all of the items therein contained are true to the best of my knowledge and belief.

Harvey Mitchell
(Signature of Registrant)

Subscribed and sworn to before me this 1 day of Aug, 1958

My commission expires My Commission Expires April 19, 1960

Frank B. Sutton
(Notary Public)

(SEAL)

CERTIFICATE OF REGISTRATION

STATE OF OREGON }
County of Marion } ss.

This is to certify that the foregoing Registration Statement was received in the office of the State Engineer on the 4th day of August, 1958, at 8:00 o'clock A.M. and has been duly recorded in said office in Book No. 17 of Registration Statements on page GR 4147

Witness my hand this 5th day of August, 1966

Clayton A. ...
(State Engineer)

By _____ (Deputy)

20.00