


Township 10S Range 7E, W.M.  
North

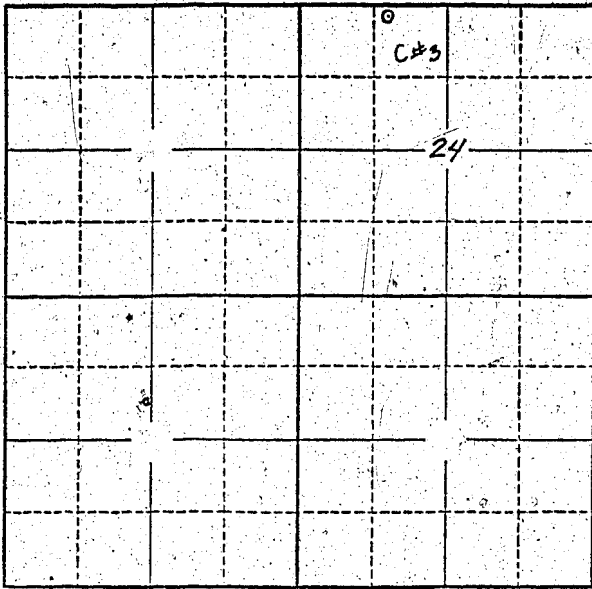

Locate well and acreage of irrigated land on plat.  
Scale: 2" = 1 Mile

STATE OF OREGON

County of Linn } ss.

I, ROBERT E. WHITE, being first duly sworn, do hereby certify that I have read the foregoing Registration Statement and that all of the items therein contained are true to the best of my knowledge and belief.

[Signature]  
(Signature of Registrant)

Subscribed and sworn to before me this 1st day of June, 1958

My commission expires MY COMMISSION EXPIRES MAY 22, 1962

[Signature]  
(Notary Public)

(SEAL)

**CERTIFICATE OF REGISTRATION**

STATE OF OREGON

County of Marion } ss.

This is to certify that the foregoing Registration Statement was received in the office of the State Engineer on the 1st day of August, 1958, at 3:45 o'clock P. M. and has been duly recorded in said office in Book No. 14 of Registration Statements on page GR-3411

Witness my hand this 20th day of August, 1959

[Signature]  
(State Engineer)

By \_\_\_\_\_  
(Deputy)

\$15.00

GR 3411