Township 11S Range 2W, W.M.

North

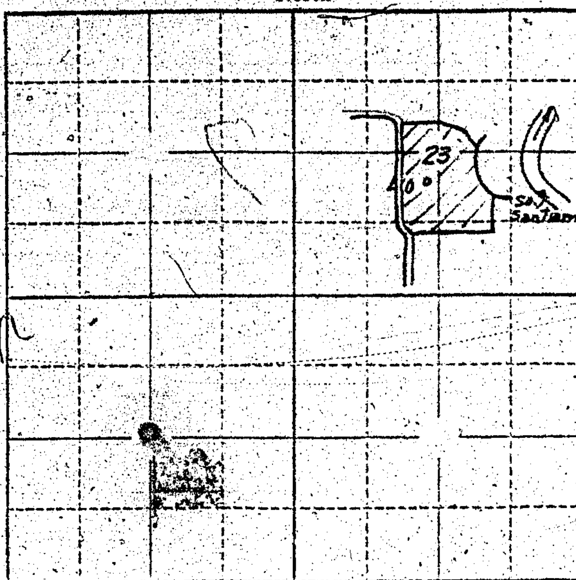

Locate well and acreage of irrigated land on plat.

Scale: 2" = 1 Mile

STATE OF OREGON
County of Linn } ss.

I, Charles G. & Henry P. Lacer, being first duly sworn, do hereby certify that I have read the foregoing Registration Statement and that all of the items therein contained are true to the best of my knowledge and belief.

Charles G. Lacer
Henry P. Lacer
(Signature of Registrant)

Subscribed and sworn to before me this 14 day of February, 1957

~~My commission expires~~ ....

R M Russell
~~(Notary Public)~~
Linn County Clerk

(SEAL)

CERTIFICATE OF REGISTRATION

STATE OF OREGON
County of Marion } ss.

This is to certify that the foregoing Registration Statement was received in the office of the State Engineer on the 18th day of February, 1957, at 8:00 o'clock A. M. and has been duly recorded in said office in Book No. 3 of Registration Statements on page GR-361 C

~~Construction shall be completed by x-x-x-x-x-x-x-x-x 19-x-x and the water completely applied to x beneficial use by x-x-x-x-x-x-x-x-x, 19x-x~~

Witness my hand this 30th day of April, 1957.

Lewis A. Stanley
(State Engineer)

By ....
(Deputy)

#1965

361 C