


Township 125 Range 6W, W.M.
North

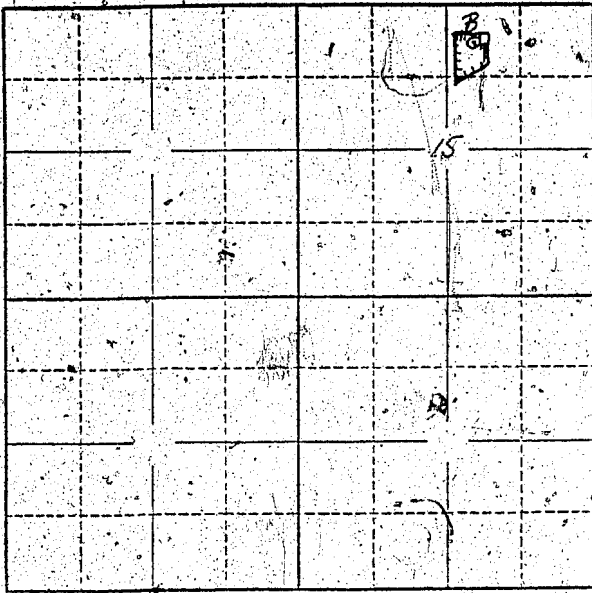

Locate well and acreage of irrigated land on plat.
Scale: 2" = 1 Mile

STATE OF OREGON

County of Polk

ss.

I, Mrs. Louise Stinson, being first duly sworn, do hereby certify that I have read the foregoing Registration Statement and that all of the items therein contained are true to the best of my knowledge and belief.

Mrs. Louise Stinson
Mrs. Louise Stinson
(Signature of Registrant)

Subscribed and sworn to before me this 31 day of July, 1958

My commission expires

10. FOR JONESON

(Notary Public)

(SEAL)

CERTIFICATE OF REGISTRATION

STATE OF OREGON

County of Marion

ss.

This is to certify that the foregoing Registration Statement was received in the office of the State Engineer on the 1st day of August, 1958, at 1:00 o'clock P.M. and has been duly recorded in said office in Book No. 16 of Registration Statements on page GR-3960

Witness my hand this 15th day of February, 1960

George A. Stanley
(State Engineer)

By

(Deputy)