


Township 12.5 Range 5W, W.M.  
North

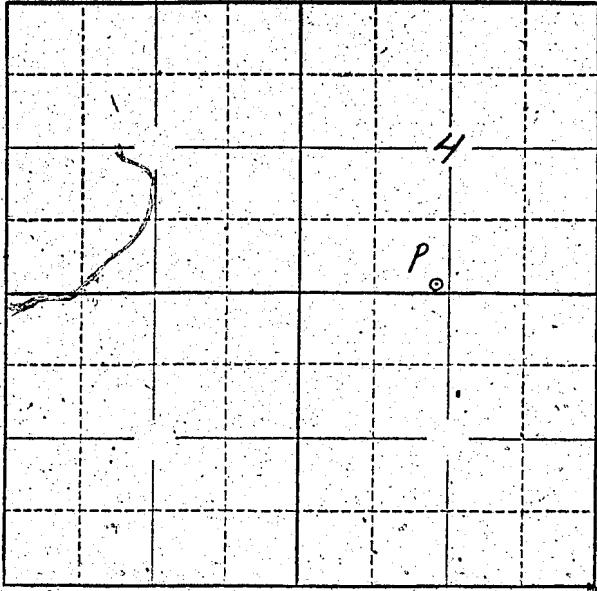

Locate well and acreage of irrigated land on plat.  
Scale: 2" = 1 Mile

STATE OF OREGON

County of \_\_\_\_\_ } ss.

I, Robert E. Reiman, being first duly sworn, do hereby certify that I have read the foregoing Registration Statement and that all of the items therein contained are true to the best of my knowledge and belief.

*Robert E. Reiman*  
(Signature of Registrant)

Subscribed and sworn to before me this 3/5 day of July, 1958

My commission expires 1/4/58 Scott Williams  
(Notary Public)

(SEAL)

**CERTIFICATE OF REGISTRATION**

STATE OF OREGON } ss.  
County of Marion

This is to certify that the foregoing Registration Statement was received in the office of the State Engineer on the 1st day of July, 1958, at 1:00 o'clock A. M. and has been duly recorded in said office in Book No. 14 of Registration Statements on page 3416

Witness my hand this 20th day of August, 1959

*Lewis A. Stanley*  
(State Engineer)

By \_\_\_\_\_ (Deputy)

\$15.00