


Township 35 Range 1E W.M.
North

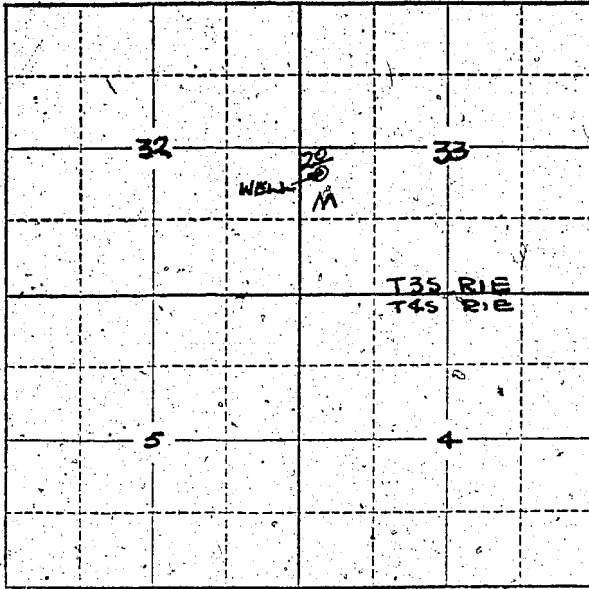

Locate well and acreage of irrigated land on plat.

Scale: 2" = 1 Mile

STATE OF OREGON

County of Clackamas

ss.

I, Mrs. John R. Meek, being first duly sworn, do hereby certify that I have read the foregoing Registration Statement and that all of the items therein contained are true to the best of my knowledge and belief.

Mrs. John R. Meek
(Signature of Registrant)

Subscribed and sworn to before me this 31 day of July, 1958

My commission expires July 22, 1961

(Notary Public)

(SEAL)

CERTIFICATE OF REGISTRATION

STATE OF OREGON

County of Marion

ss.

This is to certify that the foregoing Registration Statement was received in the office of the State Engineer on the 1 day of August, 1958, at 8:00 o'clock A. M. and has been duly recorded in said office in Book No. 14 of Registration Statements on page GR 3432

~~Construction shall be completed by _____ and the water completely applied as beneficial use by _____~~

Witness my hand this 20th day of August, 1959

Lawrence A. Stanley
(State Engineer)

By _____
(Deputy)

#15.00

GR-3432