


Township 12 S Range 3 W, W.M.
North

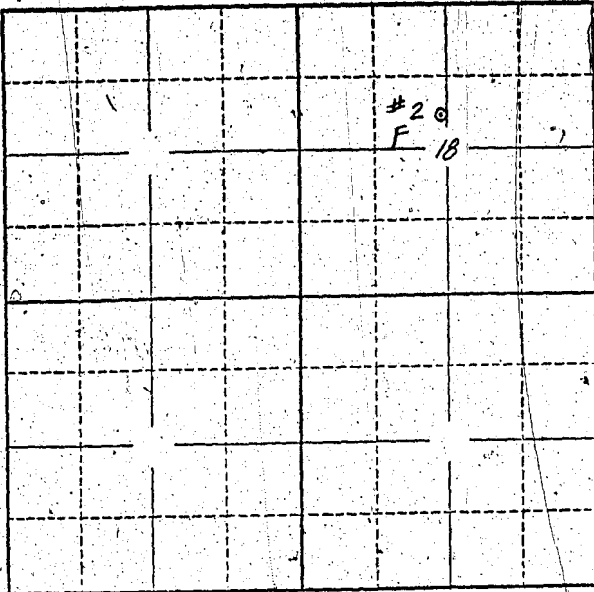

Locate well and acreage of irrigated land on plat.

Scale: 2" = 1 Mile

STATE OF OREGON
County of LINN

ss.

I, Jenks Hatchery, being first duly sworn, do hereby certify that I have read the foregoing Registration Statement and that all of the items therein contained are true to the best of my knowledge and belief.

Jenks Hatchery

[Handwritten Signature]
(Signature of Registrant)

Subscribed and sworn to before me this 30th day of July, 1958

MY COMMISSION EXPIRES JUNE 18, 1959

My commission expires _____

[Handwritten Signature]
(Notary Public)

(SEAL)

CERTIFICATE OF REGISTRATION

STATE OF OREGON
County of Marion } ss.

This is to certify that the foregoing Registration Statement, was received in the office of the State Engineer on the 1 day of August, 1958, at 8:00 o'clock A.M. and has been duly recorded in said office in Book No. 14 of Registration Statements on page 62-3436

Witness my hand this 20th day of August, 1959

[Handwritten Signature]
(State Engineer)

By _____ (Deputy)

\$15.00