


Township 12 S Range 4 W, W.M.  
North

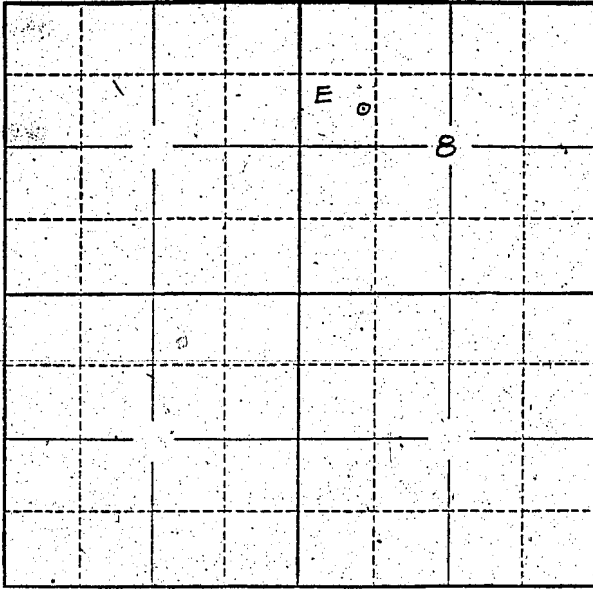

Locate well and acreage of irrigated land on plat.  
Scale: 2" = 1 Mile

STATE OF OREGON

County of ~~BOYD~~ LINN } ss.

I, Claude V. Wood, being first duly sworn, do hereby certify that I have read the foregoing Registration Statement and that all of the items therein contained are true to the best of my knowledge and belief.

*Claude V. Wood*  
(Signature of Registrant)

Subscribed and sworn to before me this 24th day of July, 1958, 19    

My commission expires Aug. 12, 1959

*Pauline Beach*  
(Notary Public)  
Notary Public for Oregon

(SEAL)

**CERTIFICATE OF REGISTRATION**

STATE OF OREGON }  
County of Marion } ss.

This is to certify that the foregoing Registration Statement was received in the office of the State Engineer on the 1 day of August, 1955, at 8:00 o'clock A. M. and has been duly recorded in said office in Book No. 14 of Registration Statements on page GR-3439

Witness my hand this 20th day of August, 1959

*Lawrence A. Stanley*  
(State Engineer)

By \_\_\_\_\_  
(Deputy)

\$15.00