


Township 11 S Range 3 W, W.M.

North

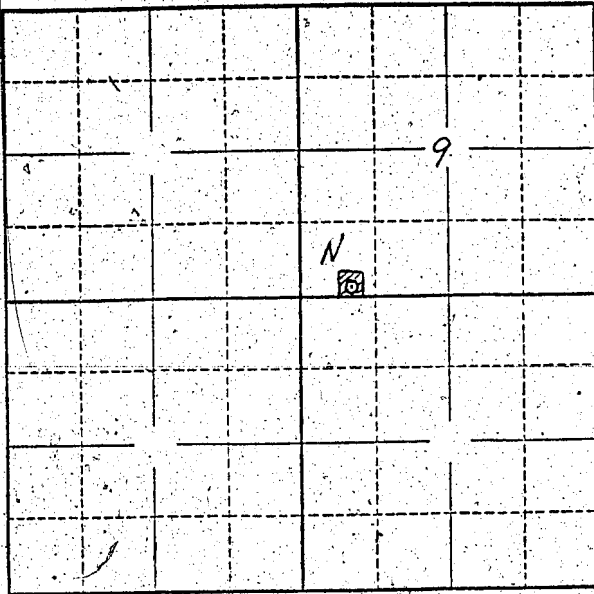

Locate well and acreage of irrigated land on plat.

Scale: 2" = 1 Mile

STATE OF OREGON

County of LINN

} ss.

I, Loray and R. S. Hannah, being first duly sworn, do hereby certify that I have read the foregoing Registration Statement and that all of the items therein contained are true to the best of my knowledge and belief.

Loray Hannah
R. S. Hannah
(Signature of Registrant)

Subscribed and sworn to before me this 29th day of July, 19 58

MY COMMISSION EXPIRES DEC. 4, 1958
My commission expires

George Andrews
(Notary Public)

(SEAL)

CERTIFICATE OF REGISTRATION

STATE OF OREGON

County of Marion

} ss.

This is to certify that the foregoing Registration Statement was received in the office of the State Engineer on the 1st day of August, 1958, at 8.00 o'clock A. M. and has been duly recorded in said office in Book No. 14 of Registration Statements on page GR-3440

Witness my hand this 20th day of August, 19 59

Laura A. Stanley
(State Engineer)

By _____ (Deputy)

\$15.00