


Township 14 S Range 4 W, W.M.
North

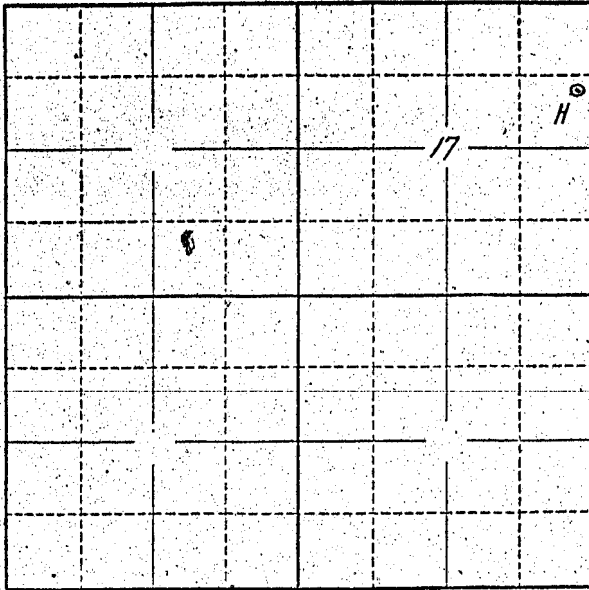

Locate well and acreage of irrigated land on plat.
Scale: 2" = 1 Mile

STATE OF OREGON

County of Linn } ss.

I, Gerald Kropp, being first duly sworn, do hereby certify that I have read the foregoing Registration Statement and that all of the items therein contained are true to the best of my knowledge and belief.

Gerald Kropp
(Signature of Registrant)

Subscribed and sworn to before me this 31 day of July, 1958

My commission expires MY COMMISSION EXPIRES MAY 22, 1962
Lillian E. Phillips
(Notary Public)

(SEAL)

CERTIFICATE OF REGISTRATION

STATE OF OREGON

County of Marion } ss.

This is to certify that the foregoing Registration Statement was received in the office of the State Engineer on the 15th day of August, 1958, at 8:00 o'clock A. M. and has been duly recorded in said office in Book No. 14 of Registration Statements on page GR-3452

Witness my hand this 15th day of September, 1959
Lillian A. Stanley
(State Engineer)

By _____
(Deputy)

16-65