


Township 11 S Range 4E5W W.M.

North

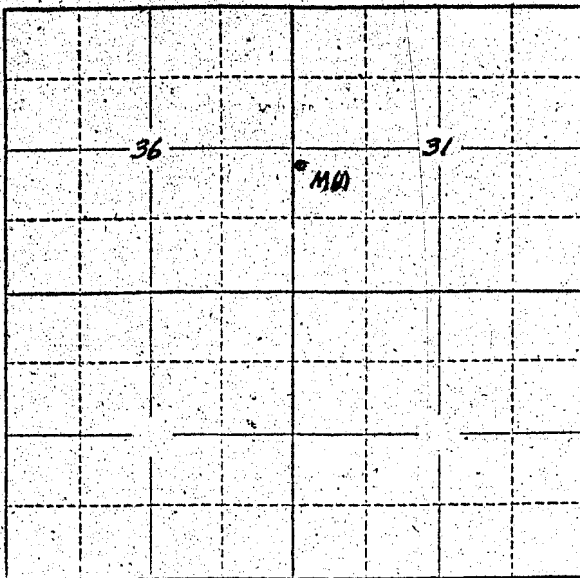

Locate well and acreage of irrigated land on plat. Scale: 2" = 1 Mile

STATE OF OREGON } ss. County of Clatsop San Mateo

I, George Van de Pol, being first duly sworn, do hereby certify that I have read the foregoing Registration Statement and that all of the items therein contained are true to the best of my knowledge and belief.

George Van de Pol (Signature of Registrant)

Subscribed and sworn to before me this 20th day of February, 1957

My commission expires Jan 9 1958 Floyd Lowe (Notary Public)

(SEAL)

See Page GR-367 G for CERTIFICATE OF REGISTRATION

STATE OF OREGON } ss. County of Marion

~~This is to certify that the foregoing Registration Statement was received in the office of the State Engineer on the ... day of ... and has been duly accepted in the office in Book ... of the Register's Office ... Construction shall be completed by ... of completely spotted off beneficial use by ...~~

Witness my hand this 30th day of April, 19 57

(State Engineer)

By (Deputy)

