Township 12S Range 4W, W.M.

North

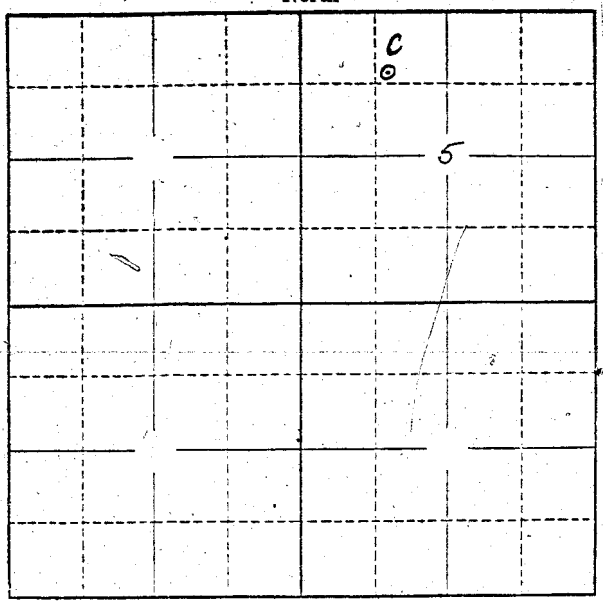

Locate well and acreage of irrigated land on plat.

Scale: 2" = 1 Mile

STATE OF OREGON
County of Linn } ss.

I, Richard C. Eisenbrandt, being first duly sworn, do hereby certify that I have read the foregoing Registration Statement and that all of the items therein contained are true to the best of my knowledge and belief.

Richard C. Eisenbrandt
(Signature of Registrant)

Subscribed and sworn to before me this 30th day of July 1958

My commission expires NOTARY PUBLIC FOR OREGON
My Commission Expires 20 March 1961

W. Walter Stanley
(Notary Public)

(SEAL)

CERTIFICATE OF REGISTRATION

STATE OF OREGON
County of Marion } ss.

A

This is to certify that the foregoing Registration Statement was received in the office of the State Engineer on the 1st day of August, 1958, at 8:00 o'clock A.M. and has been duly recorded in said office in Book No. 14 of Registration Statements on page GR-3469

Witness my hand this 15th day of September, 1959

Lewis A. Stanley
(State Engineer)

$15.00

By
(Deputy)

GR-3469