Township 17S Range 3 W W.M.

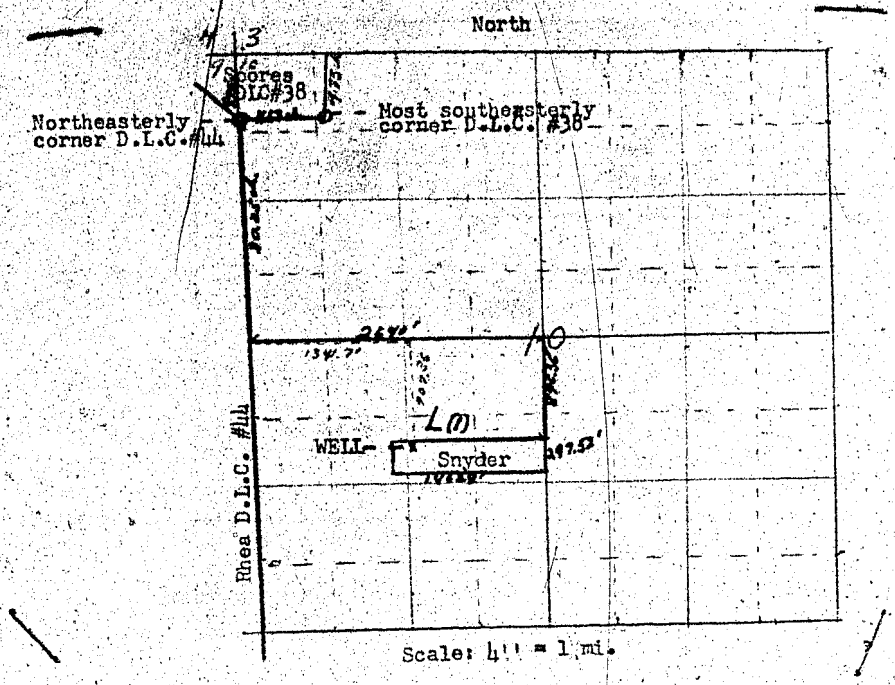

STATE OF OREGON
County of Lane } ss.

We, Roy L. Snyder and Ruth Snyder, being first duly sworn, do hereby certify that we have read the foregoing Registration Statement and that all of the items therein contained are true to the best of our knowledge and belief.

Roy L. Snyder
Ruth Snyder
(Signature of Registrant)

Subscribed and sworn to before me this 23rd day of February, 1957.

My commission expires March 26, 1959

Judith S. Hardgrave
(Notary Public) for Oregon

(SEAL)

CERTIFICATE OF REGISTRATION

STATE OF OREGON
County of Marion } ss.

This is to certify that the foregoing Registration Statement was received in the office of the State Engineer on the 28th day of February, 1957, at 8:00 o'clock A. M. and has been duly recorded in said office in Book No. 3 of Registration Statements on page GR-368 C

~~Construction shall be completed by X-X-X-X-X-X-X-X-X-X, 19X-X-X and the water could completely applied to X-X-X-X-X-X-X-X-X-X-X-X-X-X-X-X-X-X-X-X-X-X, 19X-X-X~~

Witness my hand this 30th day of April, 1957

Louis A. Stanley
(State Engineer)

By
(Deputy)

$15.00

GR 368 C