Township 2 SOUTH Range 1 WEST, W.M.

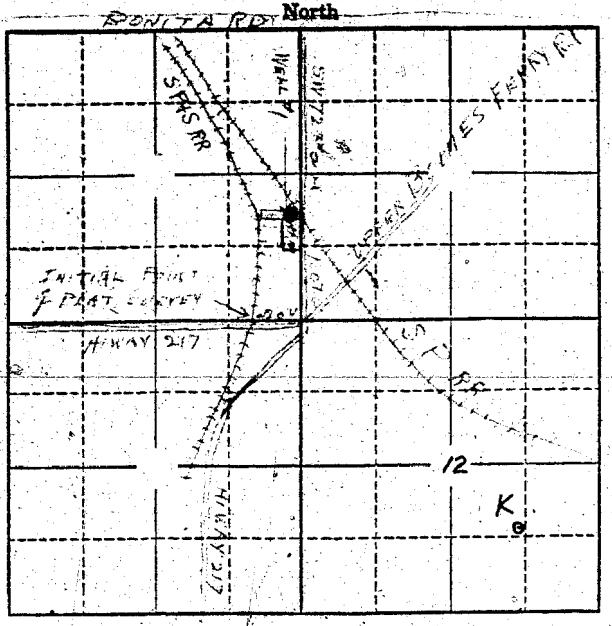

WELL LOCATED ON LOT 24 150 FT. South of Inter-Section of SW 72nd ave and Upper Boones Ferry Rd.

AREA TO BE IRRIGATED (3.96 acres) is LOTS 43 + 44 (next South)

Locate well and acreage of irrigated land on plat.

Scale: 2" — 1 Mile

STATE OF OREGON
County of Washington } ss.

I, W. C. Vanatta, being first duly sworn, do hereby certify that I have read the foregoing Registration Statement and that all of the items therein contained are true to the best of my knowledge and belief.

W C Vanatta
(Signature of Registrant)

Subscribed and sworn to before me this 31 day of July 19 58

My commission expires 9-24-58

Floyd E. Thorpe
(Notary Public)

(SEAL)

NOTARY PUBLIC FOR OREGON
My Commission Expires Sept. 24, 1958

CERTIFICATE OF REGISTRATION

STATE OF OREGON
County of Marion } ss.

This is to certify that the foregoing Registration Statement was received in the office of the State Engineer on the 1st day of August, 19 58, at 10:30 o'clock A M. and has been duly recorded in said office in Book No. 14 of Registration Statements on page GR-3472.

Witness my hand this 15th day of September 19 59

Lewis A. Stanley
(State Engineer)

$15.00

By
(Deputy)

GR 3472