


Township 1 S Range 1 W W.M. Sec Corner  
North 19 20

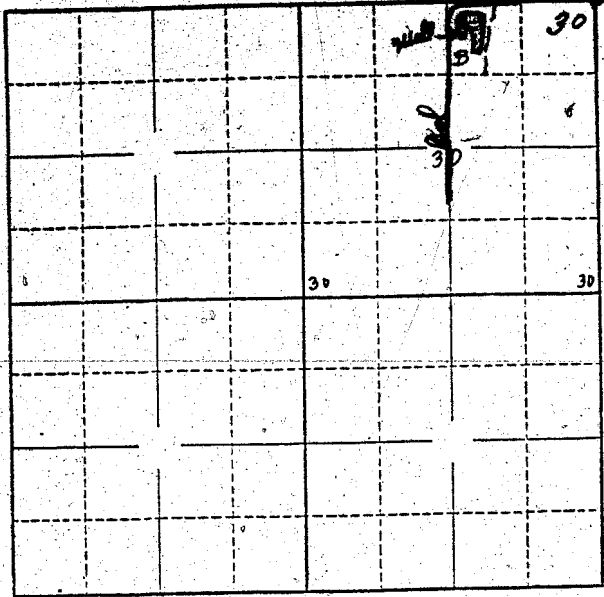

2 ACRES  
TO BE IRRIGATED

Locate well and acreage of irrigated land on plat.  
Scale: 2" = 1 Mile

STATE OF OREGON }  
County of Washington } ss.

I, Glen Brisbane, being first duly sworn, do hereby certify that I have read the foregoing Registration Statement and that all of the items therein contained are true to the best of my knowledge and belief.

Glen Brisbane  
(Signature of Registrant)

Subscribed and sworn to before me this 30 day of July, 1958

My commission expires 2-19-61  
Henry M. Tucker  
(Notary Public)

(SEAL)

**CERTIFICATE OF REGISTRATION**

STATE OF OREGON }  
County of Marion } ss.

This is to certify that the foregoing Registration Statement was received in the office of the State Engineer on the 1st day of August, 1958, at 10:30 o'clock A.M. and has been duly recorded in said office in Book No. 14 of Registration Statements on page GR-3474

Witness my hand this 15th day of September, 1959  
Wm A. Stanley  
(State Engineer)

By \_\_\_\_\_  
(Deputy)

\$15.00