


North

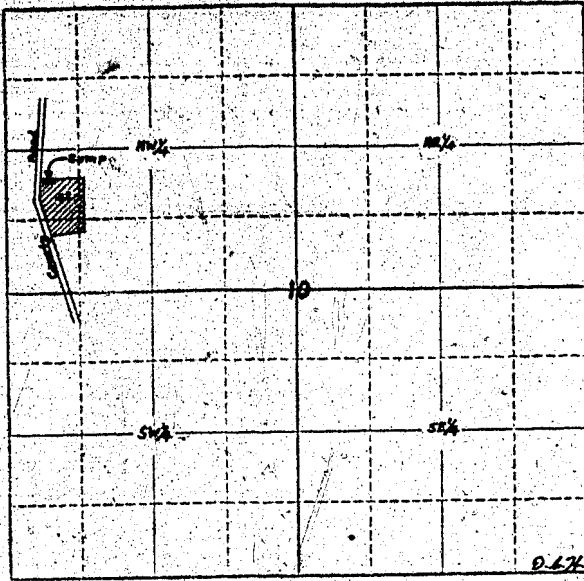

Locate well and acreage of irrigated land on plat.
Scale: 4" = 1 Mile

STATE OF OREGON

County of Jackson } ss.

I, David Bilmerstein being first duly sworn, do hereby certify that I have read the foregoing Registration Statement and that all of the items therein contained are true to the best of my knowledge and belief.

David Bilmerstein
(Signature of Registrant)

Subscribed and sworn to before me this 28th day of February, 1957

My commission expires July 31, 1959 Edith Gault
(Notary Public)

(SEAL)

CERTIFICATE OF REGISTRATION

STATE OF OREGON } ss.
County of Marion

This is to certify that the foregoing Registration Statement was received in the office of the State Engineer on the 1st day of March, 1957, at 8:00 o'clock A.M. and has been duly recorded in said office in Book No. 3 of Registration Statements on page GR-369 C.

~~Construction shall be completed by X-X-X-X-X-X-X-X-X-X-X-X and the water completely applied to benefit by X-X-X-X-X-X-X-X-X-X-X-X~~

Witness my hand this 30th day of April, 1957
Lewis A. Otterley
(State Engineer)

\$15.00

By _____ (Deputy)