


North

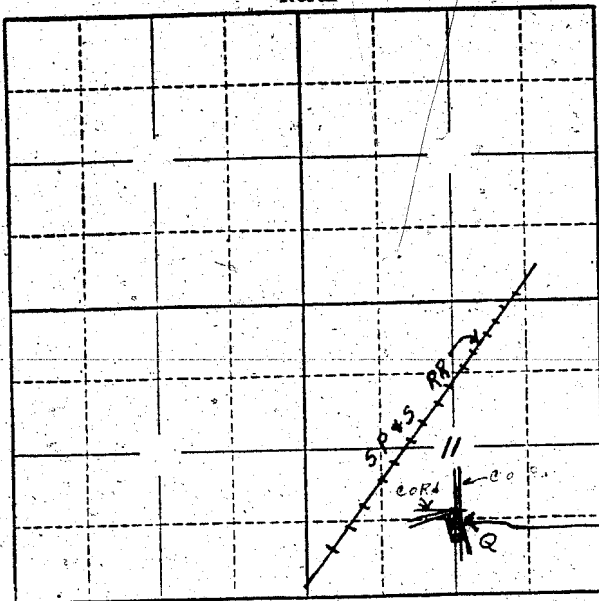

Locate well and acreage of irrigated land on plat.

Scale: 2" = 1 Mile

STATE OF OREGON

County of

} ss. *[Signature]*

I,, being first duly sworn, do hereby certify that I have read the foregoing Registration Statement and that all of the items therein contained are true to the best of my knowledge and belief.

Everett George
 (Signature of Registrant)

Subscribed and sworn to before me this 9th day of July, 1952

My commission expires 11-23-52

Ronald F. Cook
 (Notary Public)

(SEAL)

CERTIFICATE OF REGISTRATION

STATE OF OREGON

County of Marion

} ss.

This is to certify that the foregoing Registration Statement was received in the office of the State Engineer on the 1st day of August, 1958, at 4:45 o'clock P. M. and has been duly recorded in said office in Book No. 14 of Registration Statements on page GR-3493

Witness my hand this 15th day of September

1959

Henry A. Stanley
 (State Engineer)

By

(Deputy)

\$15.00