


Township 15 Range 14, W.M.
North

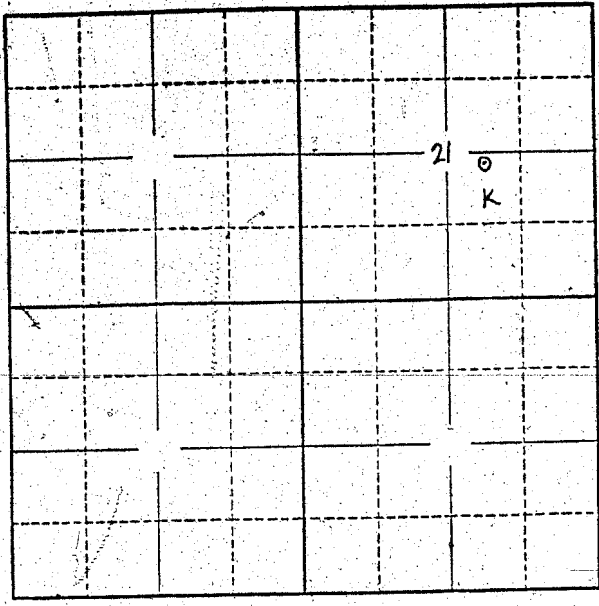

Locate well and acreage of irrigated land on plat.
Scale: 2" = 1 Mile See attached Survey Plat

STATE OF OREGON }
County of WASHINGTON } ss.

I, Robert M Stewart, being first duly sworn, do hereby certify that I have read the foregoing Registration Statement and that all of the items therein contained are true to the best of my knowledge and belief.

Robert M Stewart
(Signature of Registrant)

Subscribed and sworn to before me this 31 day of July, 1958

My commission expires 2-15-59

[Signature]
(Notary Public)

(SEAL)

CERTIFICATE OF REGISTRATION

STATE OF OREGON }
County of Marion } ss.

This is to certify that the foregoing Registration Statement was received in the office of the State Engineer on the 1 day of August, 1958, at 8:00 o'clock A.M. and has been duly recorded in said office in Book No. 14 of Registration Statements on page GR-3497

Witness my hand this 15th day of September

Lewis A. Stanley
(State Engineer)

By _____ (Deputy)

\$15.00