


Township 14 S. Range 5 W., W.M.

North

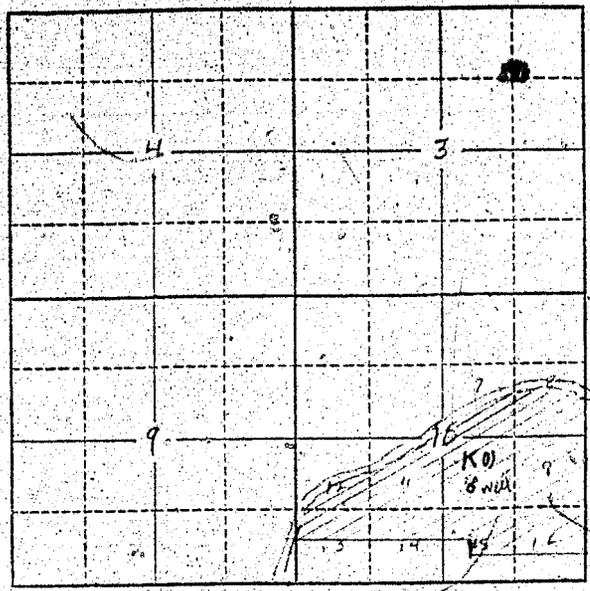

Locate well and acreage of irrigated land on plat.

Scale: 2" = 1 Mile

STATE OF OREGON

County of Bevton } ss.

I, Chris C. Lindseth, being first duly sworn, do hereby certify that I have read the foregoing Registration Statement and that all of the items therein contained are true to the best of my knowledge and belief.

Chris C. Lindseth
(Signature of Registrant)

Subscribed and sworn to before me this 5TH day of MARCH, 1957

My commission expires JULY 25, 1958

(SEAL)

A. E. Ruby
(Notary Public)

CERTIFICATE OF REGISTRATION

STATE OF OREGON

County of Marion } ss.

This is to certify that the foregoing Registration Statement was received in the office of the State Engineer on the 6th day of March, 1957, at 8:00 o'clock A. M. and has been duly recorded in said office in Book No. 3 of Registration Statements on page GR-371 C

~~Construction shall be completed by X-X-X-X-X-X-X-X-X-X-X-X-X-X-X and the water completely applied to benefit on by X-X-X-X-X-X-X-X-X-X-X-X-X-X-X~~

Witness my hand this 30th day of April, 1957
Lewis A. Stanley
(State Engineer)

31 90

By _____ (Deputy)