


Township 1 S. Range 12 E., W.M.
Township 2 S. Range 12 E., W.M.

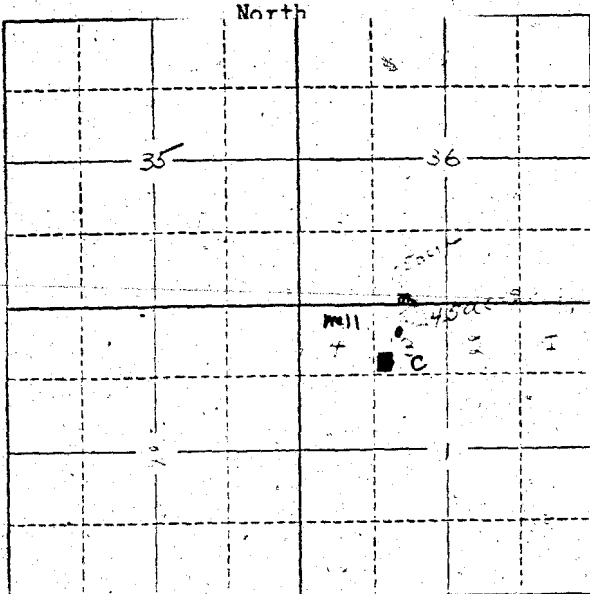

STATE OF OREGON)
County of Wasco) ss. R 12 E W 11

I, T. Leland Brown, being first duly sworn, do hereby certify that I have read the foregoing Registration Statement of Right to Appropriate Ground Water and Application for a Change in the Point of Diversion and that all of the items therein contained are true to the best of my knowledge and belief.

T. Leland Brown

Subscribed and sworn to before me this 31st day of July, 1958.

[Signature]
Notary Public for Oregon
My Commission expires: January 4, 1962

CERTIFICATE OF REGISTRATION

STATE OF OREGON)
County of Marion) ss.

This is to certify that the foregoing Registration Statement of Right to Appropriate Ground Water and Application for a Change in the Point of Diversion was received in the office of the State Engineer on the 1st day of August, 1958, at 8:00 o'clock A.M. and has been duly recorded in said office in Book No. 15 of Registration Statements on Page GR-3502.

Witness my hand this 15th day of ~~August 1958~~ September, 1959.

[Signature]
State Engineer

By _____
Deputy