


Township 5N Range 35E W.M.
North

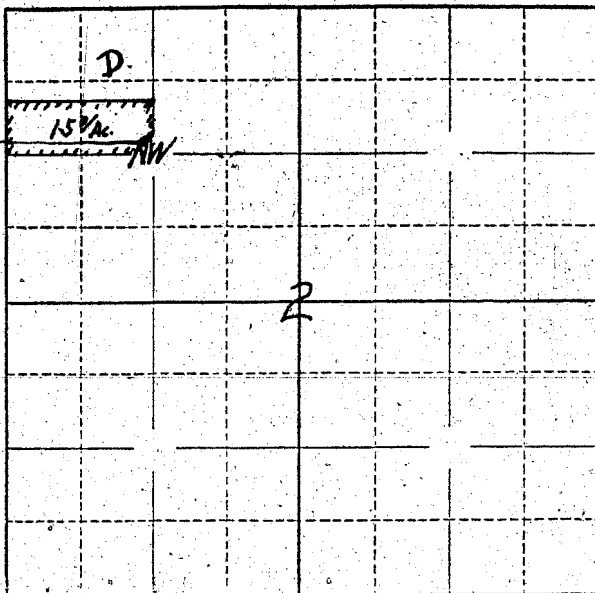

Well location
1300 feet East
& 1305 feet South
of NW corner
of Sec 2.

Locate well and acreage of irrigated land on plat.

Scale: ~~1/2~~ = 1 Mile

STATE OF OREGON

County of Wasco

} ss.

I, Gust Reichold, being first duly sworn, do hereby certify that I have read the foregoing Registration Statement and that all of the items therein contained are true to the best of my knowledge and belief.

Gust Reichold
(Signature of Registrant)

Subscribed and sworn to before me this 5th day of July, 1958.

My commission expires October 6th 1969

S. K. Dodie
(Notary Public) for Oregon

(SEAL)

CERTIFICATE OF REGISTRATION

STATE OF OREGON

County of Marion

} ss.

This is to certify that the foregoing Registration Statement was received in the office of the State Engineer on the 5th day of August, 1958, at 11:00 o'clock A. M. and has been duly recorded in said office in Book No. 15 of Registration Statements on page GR-3512.

Witness my hand this 15th day of September, 1959

Stuart A. Stanley
(State Engineer)

By _____

(Deputy)

GR 3512

\$15.00